

STATE ENGINEER
Salem, Oregon

3063
MARI....

Well Record

STATE WELL NO. 6/1W-7H (1)
COUNTY Marion
APPLICATION NO. GR-638
ALSO Appl. G-7928

OWNER: J. N. Adams


MAILING ADDRESS: Rt. 1, Box 929

LOCATION OF WELL: Owner's No. #1

CITY AND STATE: Brooks, Oregon

SE 1/4 NE 1/4 Sec. 7 T. 6 N. S., R. 1 E. W., W.M.

Bearing and distance from section or subdivision corner 1500 Feet S. & 1000 Feet W. from NE Cor. Sec. 7

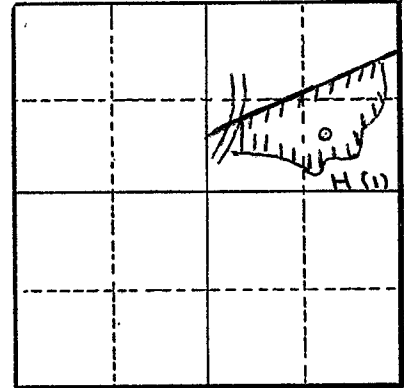

Section 7

Altitude at well 155' Interpolated

TYPE OF WELL: Drilled Date Constructed April 1948

Depth drilled 137' Depth cased 137'

CASING RECORD:
8 inch

FINISH:

AQUIFERS:

WATER LEVEL:
40'

PUMPING EQUIPMENT: Type Turbine Berkeley H.P. 7 1/2
Capacity 300 G.P.M.

WELL TESTS:
Drawdown ft. after hours G.P.M.
Drawdown ft. after hours G.P.M.

USE OF WATER Irrigation 37 acres Temp. °F., 19

SOURCE OF INFORMATION GR-638

DRILLER or DIGGER Harder Bros., McMinnville, Oregon

ADDITIONAL DATA:
Log Water Level Measurements Chemical Analysis Aquifer Test

REMARKS: