

STATE ENGINEER
Salem, Oregon

3099
MARI-99

Well Record

STATE WELL NO. 6/1W-9B(1)
COUNTY Marion
APPLICATION NO. GR-1050

GR- 1012

OWNER: M. Van Buskirk

MAILING
ADDRESS:


LOCATION OF WELL: Owner's No.

CITY AND
STATE:

Mt. Angel, Oregon

NW ¼ NE ¼ Sec. 9 T. 6 S., R. 1 W., W.M.

Bearing and distance from section or subdivision
corner 211' S. & 50' E. from N¹/₄ cor. Sec. 9.

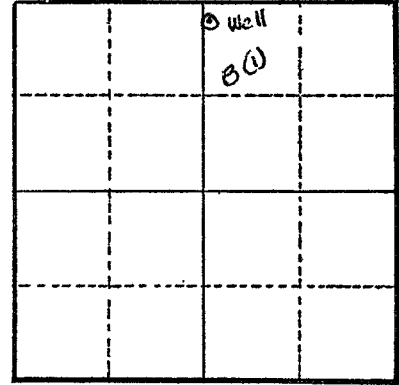

Section 9

Altitude at well 148 ft.

TYPE OF WELL: Drilled Date Constructed 1952

Depth drilled 95 ft. Depth cased 95 ft.

CASING RECORD:

~~XX~~
8 inch

FINISH:

Perforated - Unk. although some at 50 ft. & some at bottom.

AQUIFERS:

WATER LEVEL:

20 ft.

PUMPING EQUIPMENT: Type Turbine
Capacity 450 G.P.M.

H.P. 25

WELL TESTS:

Drawdown 70 ft. after hours 175 G.P.M.
Drawdown 85 ft. after hours 200 G.P.M.

USE OF WATER Irrigation Temp. °F., 19

SOURCE OF INFORMATION G.R. Record

DRILLER or DIGGER R. Stadeli

ADDITIONAL DATA:

Log Water Level Measurements Chemical Analysis Aquifer Test

REMARKS:

Log: Clay 0 to 49 ft.
Gravel 49 to 50 ft.
Gravel 50 to 95 ft.

Irrigation of 34 acres.