

STATE ENGINEER  
Salem, Oregon

3/02  
MARI.....

# Well Record

STATE WELL NO. 6/1W-9P  
COUNTY Marion  
APPLICATION NO. GR-1425

GR- 1379

OWNER: A. P. Duda


MAILING ADDRESS: Rt. 1, Box 159

LOCATION OF WELL: Owner's No. ....

CITY AND STATE: Mt. Angel, Oregon

SE 1/4 NW 1/4 Sec. 9 T. 6 S., R. 1 W., W.M.

Bearing and distance from section or subdivision  
corner 438' W. from S. 1/4 cor. Sec. 9

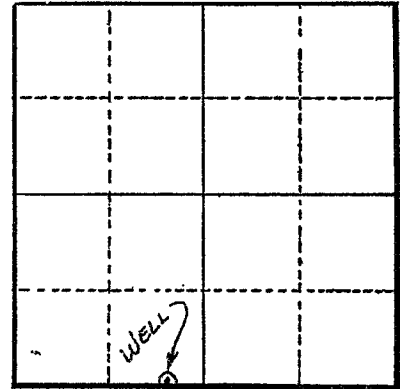

Section 9

Altitude at well

TYPE OF WELL: Drilled Date Constructed 1950

Depth drilled 173 1/2' Depth cased 173 1/2'

### CASING RECORD:

8"

### FINISH:

Perforated: about 4/ft. (1/4" x 3") from 97 1/2' to 173 1/2'

### AQUIFERS:

Water bearing gravel at 97 1/2'

Water bearing sand & gravel & cemented gravel from this level to 173 1/2'

### WATER LEVEL:

40'

### PUMPING EQUIPMENT: Type Berkeley turbine

H.P. 15

Capacity 250 G.P.M.

### WELL TESTS:

Drawdown 40 ft. after 450 hours G.P.M.

Drawdown ft. after hours G.P.M.

USE OF WATER Irrigation Temp. °F., 19

SOURCE OF INFORMATION GR Record

DRILLER or DIGGER R. Stadeli

### ADDITIONAL DATA:

Log N.A. Water Level Measurements Chemical Analysis Aquifer Test

### REMARKS:

Irrigation of 80 acres.