

STATE ENGINEER  
Salem, Oregon

3/11  
MARI.....

# Well Record


STATE WELL NO. 6/1W-10.F(1)  
COUNTY Marion  
APPLICATION NO. GR-21

OWNER: Mt. Angel Cooperative Creamery MAILING ADDRESS: \_\_\_\_\_

LOCATION OF WELL: Owner's No. #1 CITY AND STATE: Mt. Angel, Oregon

SE 1/4 NW 1/4 Sec. 10 T. 6 N. 1 W., W.M.  
S., R. 1

Bearing and distance from section or subdivision corner Lot 1, Block 2, Buttalas Add. Mt. Angel

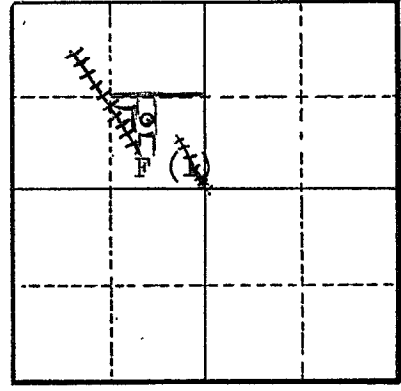

Section 10

Altitude at well 175' Interpolated

TYPE OF WELL: Drilled Date Constructed Oct. 1953

Depth drilled 85' Depth cased 85'

### CASING RECORD:

8' casing set from 0 to 85'

### FINISH:

Perforations at 60'

### AQUIFERS:

### WATER LEVEL:

25' below land surface 10/1953

PUMPING EQUIPMENT: Type Pomona H.P. 10  
Capacity 125 G.P.M.

### WELL TESTS:

Drawdown 85 ft. after \_\_\_\_\_ hours 125 G.P.M.  
Drawdown 85 ft. after \_\_\_\_\_ hours 120 G.P.M.

USE OF WATER Manufacturing Temp. °F. \_\_\_\_\_, 19

SOURCE OF INFORMATION Registration statement GR-21

DRILLER or DIGGER Rudolph Stadeli, Silverton, Oregon

### ADDITIONAL DATA:

Log No. \_\_\_\_\_ Water Level Measurements \_\_\_\_\_ Chemical Analysis \_\_\_\_\_ Aquifer Test \_\_\_\_\_

### REMARKS: