

STATE ENGINEER
Salem, Oregon


3/12
MARION

Well Record

STATE WELL NO. 6/1W-10..F(2)
COUNTY Marion
APPLICATION NO. FR-146

OWNER: City of Mt. Angel
MAILING ADDRESS: City Hall
CITY AND STATE: Mt. Angel, Oregon

LOCATION OF WELL: Owner's No. #2
AW 1/4 NW 1/4 Sec. 10 T. 6 N. S. R. 1 W., W.M.
Bearing and distance from section or subdivision
corner 1600' S. & 1460' E. from NW Cor. Sec. 10

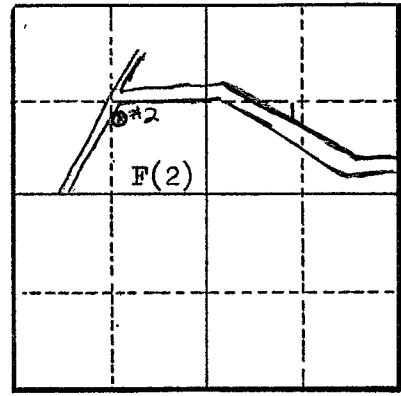

Section 10

Altitude at well 160' Interpolated
TYPE OF WELL: Drilled Date Constructed 1938
Depth drilled 117' Depth cased 117'

CASING RECORD:
12' steel casing set from 0 to 117'

FINISH:
Type unknown-perforation set from (66 to 73'
(75 to 93'
(95 to 110')

AQUIFERS:
Gravels from 32 to 108'

WATER LEVEL:
12' below land surface 2/15/56

PUMPING EQUIPMENT: Type Pomona Turbine GE H.P. 20
Capacity 220 G.P.M.

WELL TESTS:
Drawdown 60 ft. after pumping 100 hours G.P.M.
Drawdown 71 ft. after 120 hours G.P.M.

USE OF WATER Municipal Temp. °F., 19
SOURCE OF INFORMATION Registration Statement GR-146
DRILLER or DIGGER
ADDITIONAL DATA:
Log Yes Water Level Measurements Chemical Analysis Aquifer Test

REMARKS:

STATE ENGINEER
Salem, Oregon

Well Log

State Well No. 6/1W-10 F(2)
 County Marion
 Application No. GR-146

Owner: City of Mt. Angel, Oregon
 Owner's No. #2

Driller: _____ Date Drilled 1938

Thickness (feet)	CHARACTER OF MATERIAL	
	From	To
18	0	18
14	18	32
33	32	65
5	65	70
17	70	87
1	87	88
16	88	104
4	104	108
9	108	117