

STATE ENGINEER  
Salem, Oregon

3/15  
MARION

# Well Record


STATE WELL NO. 6/1W-10G (1)  
COUNTY Marion  
APPLICATION NO. GR-146

OWNER: City of Mt. Angel MAILING ADDRESS: City Hall

LOCATION OF WELL: Owner's No. #1 CITY AND STATE: Mt. Angel, Oregon

SW  $\frac{1}{4}$  NE  $\frac{1}{4}$  Sec. 10 T. 6 N. S., R. 1 E. W., W.M.

Bearing and distance from section or subdivision  
corner 1800' S & 1500' W from NE Cor. Sec. 10

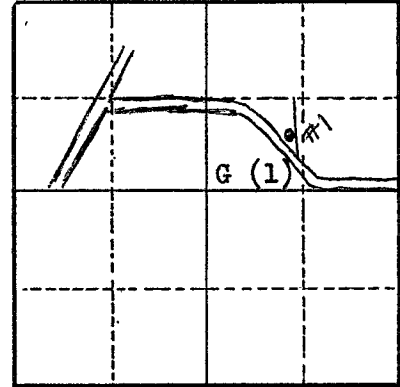

Section 10

Altitude at well 200' Interpolated

TYPE OF WELL Drilled Date Constructed 1925

Depth drilled 235' Depth cased 235'

### CASING RECORD:

12'' steel casing set from 0 to 235'

FINISH:  
Type unknown-perforations set from-  $\left\{ \begin{array}{l} 90 \text{ to } 110' \\ 140 \text{ to } 160' \\ 225 \text{ to } 235' \end{array} \right.$

### AQUIFERS:

Unknown

### WATER LEVEL:

30' below land surface Nov. 1955

PUMPING EQUIPMENT: Type U.S. Turbine GE H.P. 30  
Capacity 300 G.P.M.

### WELL TESTS:

Drawdown 40 ft. after            hours pumping 220 G.P.M.  
Drawdown 60 ft. after            hours " 240 G.P.M.

USE OF WATER Municipal Temp.            °F., 19          

SOURCE OF INFORMATION Registration Statement GR-146

DRILLER or DIGGER           

### ADDITIONAL DATA:

Log No.            Water Level Measurements            Chemical Analysis            Aquifer Test           

### REMARKS: