

STATE ENGINEER
Salem, Oregon




Well Record

STATE WELL NO. 6/1W-10-L(1)
COUNTY Marion
APPLICATION NO. GR-169

OWNER: Benedictine Sisters
MAILING ADDRESS: _____
CITY AND STATE: Mt. Angel, Oregon

LOCATION OF WELL: Owner's No. #1
NE 1/4 SW 1/4 Sec 10 T. 6 N. S. R. 1 W., W.M.
Bearing and distance from section or subdivision
corner 450' S. & 2800' W. from re-entrant
corner on E line of Clearer D.L.C. #51

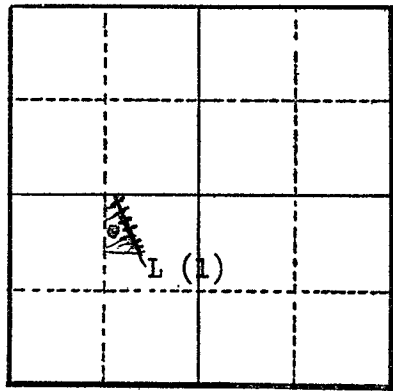

Section 10

Altitude at well 168' Interpolated

TYPE OF WELL: Drilled Date Constructed 1907
Depth drilled 173' Depth cased _____

CASING RECORD:

No record

FINISH:

No record

AQUIFERS:

No record

WATER LEVEL:

20' below land surface

PUMPING EQUIPMENT: Type Pomona Turbind H.P. 3
Capacity 80 G.P.M.

WELL TESTS:

Drawdown _____ ft. after _____ hours pumping 80 G.P.M.
Drawdown _____ ft. after _____ hours _____ G.P.M.

USE OF WATER Irrigation 3.5 Acres Temp. _____ °F., 19

SOURCE OF INFORMATION Registration statement GR-169

DRILLER or DIGGER E. Howes & Co., Portland, Oregon

ADDITIONAL DATA:

Log No _____ Water Level Measurements _____ Chemical Analysis _____ Aquifer Test _____

REMARKS: