

STATE ENGINEER
Salem, Oregon

3/18
MARION

Well Record


STATE WELL NO. 6/1W-10 L(2)
COUNTY Marion
APPLICATION NO. GR-169

OWNER: Benedictine Sisters MAILING ADDRESS: _____

LOCATION OF WELL: Owner's No. #2 CITY AND STATE: Mt. Angel, Oregon

NE ¼ SW ¼ Sec. 10 T. 6 N. S., R. 1 W., W.M.

Bearing and distance from section or subdivision
corner 175' S. & 1300' W. from re-entrant Cor. on
E. line of Clearer D.L.C. #51

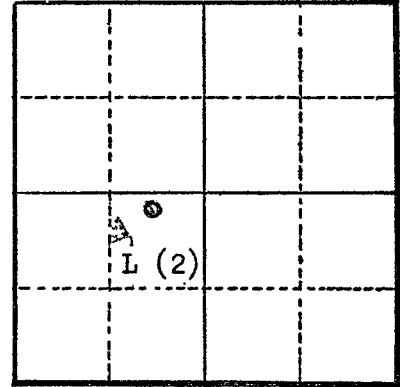

Altitude at well 168' Interpolated

TYPE OF WELL Drilled Date Constructed Aug. 1, 1939

Depth drilled 183' Depth cased 183'

Section 10

CASING RECORD:

6" casing set from 0 to 183'

FINISH:

3/8" x 1/2" slots set from--
(46 to 55'
(78 to 95'
(130 to 170'

AQUIFERS:

Gravels from 34 to 183'

WATER LEVEL:

20' below land surface 9/5/39

PUMPING EQUIPMENT: Type U.S. Pump H.P. 15
Capacity 300 G.P.M.

WELL TESTS:

Drawdown 140 ft. after _____ hours pumping 300 G.P.M.
Drawdown _____ ft. after _____ hours _____ G.P.M.

USE OF WATER Irrigation 40 acres Temp. _____ °F., 19

SOURCE OF INFORMATION Registration Statement GR-169

DRILLER or DIGGER Byron Ballweber, Woodburn, Oregon

ADDITIONAL DATA:

Log X Water Level Measurements _____ Chemical Analysis _____ Aquifer Test _____

REMARKS:

STATE ENGINEER
Salem, Oregon

Well Log

State Well No. 6/1W-10.L(3)
 County Marion
 Application No. GR-159

Owner: Benedictine Sisters

Owner's No. #2

Driller: Byron Ballweber

Date Drilled 8/1/39

Thickness (feet)	CHARACTER OF MATERIAL	
	From	To
34	0	34
21	34	55
11	55	66
1	66	67
11	67	78
32	78	110
10	110	120
20	120	140
2	140	142
41	142	183