

STATE ENGINEER
Salem, Oregon

3/5/2
MARION

Well Record

STATE WELL NO. 6/1W-12B(1)
COUNTY Marion
APPLICATION NO. GR-1060

GR- 1022

OWNER: Edwin Nickodemus


MAILING ADDRESS: Rt. 1

LOCATION OF WELL: Owner's No.

CITY AND STATE: Mt. Angel, Oregon

NW 1/4 NE 1/4 Sec. 12 T. 6 S. R. 1 W., W.M.

Bearing and distance from section or subdivision corner 2474' W. & 375' S. from NE cor. Sec. 12.

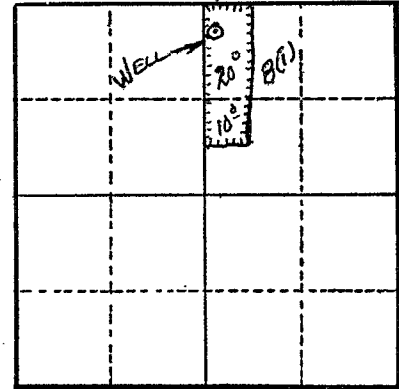

Section 12

Altitude at well 230 ft.

TYPE OF WELL: Drilled Date Constructed 1949

Depth drilled 265 ft. Depth cased 225 ft.

CASING RECORD:

8 inch

FINISH:

AQUIFERS:

WATER LEVEL:

60 ft.

PUMPING EQUIPMENT: Type Jacuzzi submersible H.P. 5

Capacity 60 G.P.M.

WELL TESTS:

Drawdown 220 ft. after 45 hours G.P.M.

Drawdown ft. after hours G.P.M.

USE OF WATER Irrigation Temp. °F., 19

SOURCE OF INFORMATION G.R. Record

DRILLER or DIGGER E. Stadel

ADDITIONAL DATA:

Log Water Level Measurements Chemical Analysis Aquifer Test

REMARKS:

Log: Volcanic rock from 6 to 265 ft.

Irrigation of 30 acres.