

STATE ENGINEER
Salem, Oregon

3163
MARION

Well Record


STATE WELL NO. 6/1W-13J
COUNTY MARION
APPLICATION NO. GR-2628

OWNER: Oscar H. Loe
MAILING ADDRESS: Rt. 1, Box 144

LOCATION OF WELL: Owner's No. #3
CITY AND STATE: Silverton, Oregon

NE 1/4 SE 1/4 Sec. 13 T. 6 S., R. 1 W., W.M.

Bearing and distance from section or subdivision corner N. 7° 21' W. 2355'

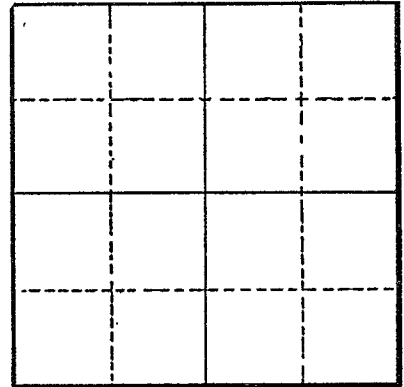

Section

Altitude at well

TYPE OF WELL: Drilled Date Constructed 1951

Depth drilled 182 Depth cased 52

CASING RECORD:

12-inch

FINISH:

AQUIFERS:

Topsoil, gravel, clay and rock

WATER LEVEL:

21-feet

PUMPING EQUIPMENT: Type Fairbanks H.P. 10
Capacity 200 G.P.M.

WELL TESTS:

Drawdown 39 ft. after hours Pumping 150 G.P.M.
Drawdown ft. after hours G.P.M.

USE OF WATER Irrigation Temp. °F., 19

SOURCE OF INFORMATION GR-2493

DRILLER or DIGGER Harty Brothers 3115 SW Illinois St., Portland 1, Oregon

ADDITIONAL DATA:

Log Water Level Measurements Chemical Analysis Aquifer Test

REMARKS:

Topsoil	0	13	
Gravel	13	21	
Yellow clay	21	53	
Cemented gravel	53	116	some water
Rock	116	182	