

STATE ENGINEER
Salem, Oregon

3189
MARI.....

Well Record


STATE WELL NO. 6/1W-15 D(1)
COUNTY Marion
APPLICATION NO. GR-346

OWNER: Frank Boepping
MAILING ADDRESS: Box 157

LOCATION OF WELL: Owner's No. _____
CITY AND STATE: Mt. Angel, Oregon

NW 1/4 NW 1/4 Sec 15 T. 6 S. R. 1 W., W.M.

Bearing and distance from section or subdivision
corner 942' S. & 270.1' E. from NW Cor. Sec. 15

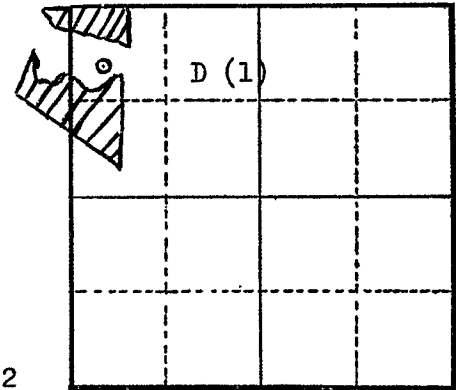

Altitude at well 175

TYPE OF WELL: Drilled Date Constructed April 1, 1952

Depth drilled 144'8" Depth cased 144'8"

Section 15

CASING RECORD:

8"

FINISH:

AQUIFERS:

WATER LEVEL:

15

PUMPING EQUIPMENT: Type Turbine H.P. 25
Capacity 375 G.P.M.

WELL TESTS:

Drawdown _____ ft. after _____ hours _____ G.P.M.

Drawdown _____ ft. after _____ hours _____ G.P.M.

USE OF WATER Irrigation Temp. _____ °F., 19

SOURCE OF INFORMATION Ground Water Registration Record

DRILLER or DIGGER R. Stadel

ADDITIONAL DATA:

Log _____ Water Level Measurements _____ Chemical Analysis _____ Aquifer Test _____

REMARKS:

Blue Clay 0 to 10
Cemented gravel 10 to 144'8"