

STATE ENGINEER  
Salem, Oregon

3231  
MARION

# Well Record


STATE WELL NO. 6/W-18D  
COUNTY Marion  
APPLICATION NO. GR-3881

OWNER: Dorothy Werner & Dwayne Werner Mailing ADDRESS: Route 1, Box 103

LOCATION OF WELL: Owner's No. CITY AND STATE: Brooks, Oregon

NW 1/4 NW 1/4 Sec. 18 T. 6 S. R. 1 W., W.M.

Bearing and distance from section or subdivision corner From common corner of Sec. 7-18; S. 5 chs.; W. 8 chs.

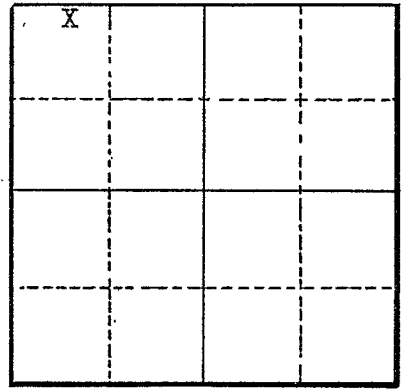

Section 18

Altitude at well

TYPE OF WELL: Drilled Date Constructed

Depth drilled 106 ft. Depth cased

### CASING RECORD:

### FINISH:

### AQUIFERS:

### WATER LEVEL:

PUMPING EQUIPMENT: Type Dorward jet H.P. 3  
Capacity 70 ? G.P.M.

### WELL TESTS:

Drawdown ft. after hours G.P.M.  
Drawdown ft. after hours G.P.M.

USE OF WATER Irrigation Temp. °F, 19  
SOURCE OF INFORMATION Well Registration Statement Cert. # GR-3530

DRILLER or DIGGER

### ADDITIONAL DATA:

Log Water Level Measurements Chemical Analysis Aquifer Test

### REMARKS: