

STATE ENGINEER
Salem, Oregon

3252
MARI.....


Well Record

STATE WELL NO. 6/LW-19L
COUNTY Marion
APPLICATION NO. GR-3617

OWNER: Marie Monllet
MAILING ADDRESS: Route 2, Box 212
CITY AND STATE: Silverton, Oregon

LOCATION OF WELL: Owner's No. _____
NE 1/4 SW 1/4 Sec. 19 T. 6 N. S. R. 1 W., W.M.

Bearing and distance from section or subdivision
corner 346.5 ft. S. 22.09 ft. W. & 1108.5 ft. N. 71°
E. & 165 ft. S. from the N. NW cor. Samuel
Simmons D.L.G.

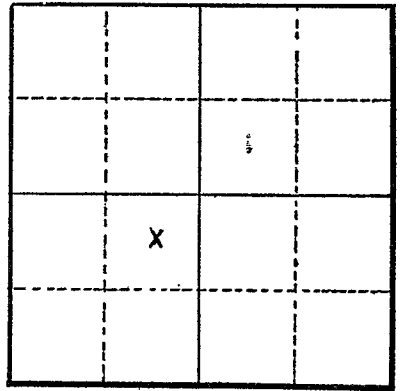

Section 19

Altitude at well _____

TYPE OF WELL: Drilled Date Constructed Fall, 1948
Depth drilled 130 ft. Depth cased 130 ft.

CASING RECORD:

6 inch casing set to 130 feet

FINISH:

no perforations

AQUIFERS:

WATER LEVEL:

120 feet below surface

PUMPING EQUIPMENT: Type Pamona Turbine electric H.P. 3
Capacity 50 G.P.M.

WELL TESTS:

Drawdown _____ ft. after _____ hours _____ G.P.M.
Drawdown _____ ft. after _____ hours _____ G.P.M.

USE OF WATER Irrigation Temp. _____ °F., 19

SOURCE OF INFORMATION Well Registration Statement

DRILLER or DIGGER Stadli

ADDITIONAL DATA:

Log _____ Water Level Measurements _____ Chemical Analysis _____ Aquifer Test _____

REMARKS: