

STATE ENGINEER
Salem, Oregon


3253
MARI...3

Well Record

STATE WELL NO. 6/1W-19M
COUNTY Marion
APPLICATION NO. GR-4129

OWNER: Fred R. Landt
MAILING ADDRESS: Route 2, Box 208 A
CITY AND STATE: Silverton, Oregon

LOCATION OF WELL: Owner's No. NW 1/4 SW 1/4 Sec. 19 T. 6 S., R. 1 W., W.M.
Bearing and distance from section or subdivision corner 260' East and 1050' South from the W1/4 cor., Section 19.

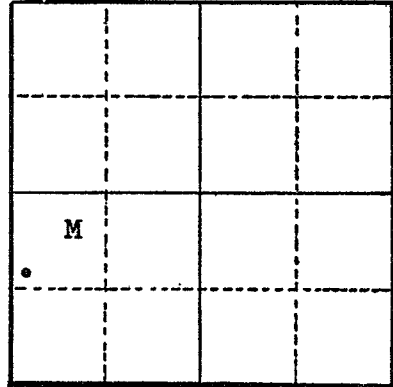

Altitude at well 200 feet

TYPE OF WELL: Drilled Date Constructed 1951
Depth drilled 156 feet Depth cased

Section 19

CASING RECORD:

6"

FINISH:

AQUIFERS:

sand and gravels

WATER LEVEL:

35 feet

PUMPING EQUIPMENT: Type Century set H.P. 3
Capacity 30 G.P.M.

WELL TESTS:

Drawdown 40 ft. after 120 hours G.P.M.
Drawdown ft. after hours G.P.M.

USE OF WATER Irrigation Temp. °F. 19

SOURCE OF INFORMATION GR-4010

DRILLER or DIGGER

ADDITIONAL DATA:

Log Water Level Measurements Chemical Analysis Aquifer Test

REMARKS:

top soil	3	3
silt & clay	35	38
shale	25	63
sandy shale	19	82
sand	26	108
gravel and water	37	140
cemented gravel		



Oregon Water Resources Department
725 Summer Street NE, Suite A
Salem Oregon 97301
(503) 986-0900
www.wrd.state.or.us

RECEIVED BY OWRD

Application for Well ID Number

OCT 25 2013

SALEM, OR

Do not complete if the well already has a Well I.D Number.

I. OWNER INFORMATION

Current Owner Name (please print): Jeffrey and Teresa Fossholm
Mailing Address: 9562 Nusom Rd NE
City, State, Zip: Silverton, OR 97381
Address to send Well I.D. Tag: Same as above
City, State, Zip:

II. WELL INFORMATION (Do not complete this section if the well report is attached.)

Township: (North/South) Range: (East/West) Section:
Tax Lot: County 1/4 1/4
Street Address of Well, City: same as above
Owner at time the well was constructed, (if known):
If the property had a different street address in the past:

III. GENERAL WELL INFORMATION (Do not complete this section if the well report is attached)

Use of Well (domestic, irrigation, commercial, industrial, monitoring): domestic
Date Well Constructed: Total Well Depth: Casing Diameter:
Other Information:

SUBMITTED BY (please print): Teresa Fossholm
PHONE: 503-507-8396 FAX:

Send application to Oregon Water Resources Department; 725 Summer St NE, Suite A; Salem, Oregon 97301-1266; fax (503) 986-0902. Applications are processed and Well I.D. Numbers are mailed every Wednesday.

For Official Use Only by the Oregon Water Resources Department:
Received Date: 10-25-13
Well Log Number: MARI 3253
Well: L
Identification #: 112796