

STATE ENGINEER
Salem, Oregon

3282
MARI.....

Well Record

STATE WELL NO. 6/1W-21-G(1)
COUNTY Marion
APPLICATION NO. GR-1212

GR- 1172

OWNER: Matt Schultz


MAILING ADDRESS: Rt. 2, Box 158

LOCATION OF WELL: Owner's No.

CITY AND STATE: Silverton, Oregon

NE 1/4 NW 1/4 Sec. 21 T. 6 S., R. 1 W., W.M.

Bearing and distance from section or subdivision corner S. 79° 45' E. 1870' from NW cor. Sec. 21.

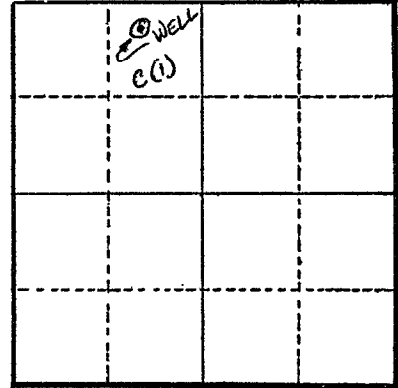

Section 21

Altitude at well 173 ft.

TYPE OF WELL: Drilled Date Constructed 1942

Depth drilled 104 ft. Depth cased 104 ft.

CASING RECORD:

8 inch

FINISH:

Perforated at 62 ft. & at the bottom.

AQUIFERS:

Most of the water is obtained from gravel at 104 ft.

WATER LEVEL:

13 ft.

PUMPING EQUIPMENT: Type Turbine H.P. 3
Capacity 50 G.P.M.

WELL TESTS:

Drawdown ft. after hours G.P.M.
Drawdown ft. after hours G.P.M.

USE OF WATER Irrigation Temp. °F., 19

SOURCE OF INFORMATION G. R. Record

DRILLER or DIGGER John Beck from 0 to 60 ft. & J.A. Sneed from 60 to 104 ft.

ADDITIONAL DATA:

Log N.A. Water Level Measurements Chemical Analysis Aquifer Test

REMARKS:

Irrigation of 8.95 Ac.