

STATE ENGINEER
Salem, Oregon

3307
MARI...

Well Record

STATE WELL NO. 6/1W-22C
COUNTY Marion
APPLICATION NO. GR-3103

OWNER: Bernard and Eldred Schiedler


MAILING ADDRESS: Route 1, Box 128

LOCATION OF WELL: Owner's No. "A"

CITY AND STATE: Mount Angel, Oregon

NE 1/4 NW 1/4 Sec. 22 T. 6 S., R. 1 W., W.M.

Bearing and distance from section or subdivision corner S. 85 30' E., 2440'

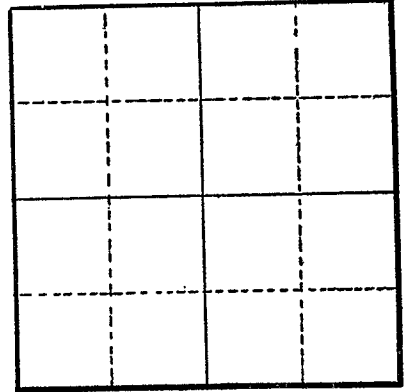

Section

Altitude at well

TYPE OF WELL: drilled Date Constructed 1937

Depth drilled 92' Depth cased 92'

CASING RECORD:

6 inch

FINISH:

AQUIFERS:

WATER LEVEL:

18 feet

PUMPING EQUIPMENT: Type Jet Dorward Red Jacket H.P. 1 1/2
Capacity 30 G.P.M.

WELL TESTS:

Drawdown 85 ft. after _____ hours pumping 30 G.P.M.
Drawdown _____ ft. after _____ hours _____ G.P.M.

USE OF WATER Irrigation Temp. _____ °F., 19

SOURCE OF INFORMATION GR-2911

DRILLER or DIGGER

ADDITIONAL DATA:
Log _____ Water Level Measurements _____ Chemical Analysis _____ Aquifer Test _____

REMARKS: