

STATE ENGINEER  
Salem, Oregon

MARI 3326 Well Record

STATE WELL NO. 6/1W-24A(1)  
COUNTY Marion  
APPLICATION NO. GR-993

GR- 962

OWNER: Arthur Lewis Rutschman


MAILING ADDRESS: Rt. 1, Box 365

LOCATION OF WELL: Owner's No.

CITY AND STATE: Silverton, Oregon

NE 1/4 NE 1/4 Sec. 24 T. 6 S., R. 1 W., W.M.

Bearing and distance from section or subdivision corner 1250' W. & 10' S. of NE cor. Sec. 24.

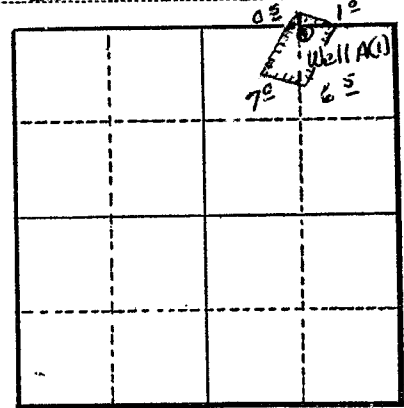

Section 24

Altitude at well 275 ft.

TYPE OF WELL: Drilled Date Constructed 1947

Depth drilled 225 ft. Depth cased 168 ft.

CASING RECORD:

6 inch

FINISH:

AQUIFERS:

WATER LEVEL:

PUMPING EQUIPMENT: Type Berkeley submersible H.P. 3  
Capacity G.P.M.

WELL TESTS:

Drawdown ft. after hours G.P.M.  
Drawdown ft. after hours G.P.M.

USE OF WATER Irrigation Temp. °F., 19.

SOURCE OF INFORMATION G.R. Record

DRILLER or DIGGER

ADDITIONAL DATA:

Log N.A. Water Level Measurements Chemical Analysis Aquifer Test

REMARKS:

Irrigation of 15 acres.