

STATE ENGINEER
Salem, Oregon

3342
MARI.....

Well Record

STATE WELL NO. 6/1W-25
COUNTY MARION
APPLICATION NO. GR-2651

OWNER: Joe Gubbels & Verona Gubbels


MAILING ADDRESS: Rt. 1, Box 125

LOCATION OF WELL: Owner's No.

CITY AND STATE: Silverton, Oregon

SE $\frac{1}{4}$ SW $\frac{1}{4}$ NE $\frac{1}{4}$ Sec. 25 T. 6 N S., R. 1 W., W.M.

Bearing and distance from section or subdivision corner $1\frac{1}{2}$ mile East on State Highway #213.

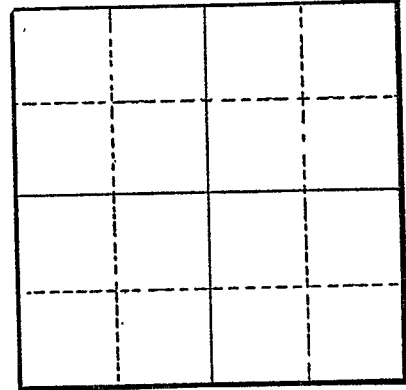

Section

Altitude at well

TYPE OF WELL: Trench Date Constructed 1949

Depth drilled 9 Depth cased 8

CASING RECORD:

FINISH:

AQUIFERS:

WATER LEVEL:

PUMPING EQUIPMENT: Type Sears Pump Centrifugal H.P. 4
Capacity 60 G.P.M.

WELL TESTS:

Drawdown ft. after hours G.P.M.
Drawdown ft. after hours G.P.M.

USE OF WATER Irrigation Temp. °F., 19.

SOURCE OF INFORMATION GR-2513

DRILLER or DIGGER

ADDITIONAL DATA:

Log Water Level Measurements Chemical Analysis Aquifer Test

REMARKS: