

STATE ENGINEER  
Salem, Oregon

3365  
MAR 1945

# Well Record

STATE WELL NO. 6/1W-25K(1)  
COUNTY Marion  
APPLICATION NO. GR-1183

GR- 1144

OWNER: Fred C. Warnock


MAILING ADDRESS: Rt. 1, Box 126

LOCATION OF WELL: Owner's No.

CITY AND STATE: Silverton, Oregon

NW 1/4 SE 1/4 Sec. 25 T. 6 S. R. 1 W., W.M.

Bearing and distance from section or subdivision corner 2000' N. & 850' E. from SW cor. Sec. 25.

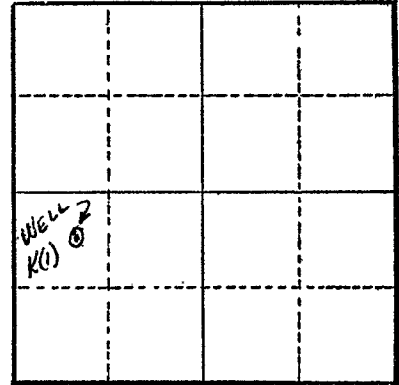

Section 25

Altitude at well 320 ft.

TYPE OF WELL: Drilled Date Constructed 1940

Depth drilled 207 ft. Depth cased 16 ft.

### CASING RECORD:

6 inch from top to 16 ft.

### FINISH:

### AQUIFERS:

### WATER LEVEL:

130 ft.

PUMPING EQUIPMENT: Type Berkeley submersible H.P. 1  
Capacity 22.4 G.P.M.

### WELL TESTS:

Drawdown 160 ft. after 22.4 hours G.P.M.

Drawdown ft. after hours G.P.M.

USE OF WATER Irrigation Temp. °F. 19

SOURCE OF INFORMATION G. R. Record

DRILLER or DIGGER Rudolph Stadel

### ADDITIONAL DATA:

Log N.A. Water Level Measurements Chemical Analysis Aquifer Test

### REMARKS:

Irrigation of 6 acres.