

STATE ENGINEER
Salem, Oregon

3408 MAR 1935
MAR 1935 Well Record

STATE WELL NO. 6/1W-26 P(1)
COUNTY Marion
APPLICATION NO. GR-367

OWNER: City of Silverton

MAILING
ADDRESS:

LOCATION OF WELL: Owner's No.


CITY AND

STATE: Silverton, Oregon

SE 1/4 SW 1/4 Sec. 26 T. 6 N. S. R. 1 E. W., W.M.

Bearing and distance from section or subdivision

corner 928' N. & 270' W. from NE Cor. of City of
Silverton Boundary (S 1/4 Cor. Sec. 26)

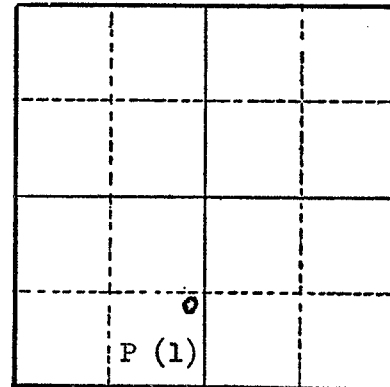

Altitude at well 248

TYPE OF WELL: Drilled Date Constructed May 22, 1935

Depth drilled 183 Depth cased

Section 26

CASING RECORD:

12"

FINISH:

AQUIFERS:

WATER LEVEL:

15.5

PUMPING EQUIPMENT: Type Sterling Turbine 10" 10" H.P. 60
Capacity 500 G.P.M.

WELL TESTS:

Drawdown ft. after hours G.P.M.

Drawdown ft. after hours G.P.M.

USE OF WATER Municipal Temp. °F., 19

SOURCE OF INFORMATION Ground Water Registration Record

DRILLER or DIGGER R. J. Strasser Drilling Co., Portland, Oregon

ADDITIONAL DATA:

Log X Water Level Measurements Chemical Analysis Aquifer Test

REMARKS:

[illegible]