

STATE ENGINEER
Salem, Oregon

34
MAR 10 1936

Well Record

STATE WELL NO. 6/1W-26 R(1)
COUNTY Marion
APPLICATION NO. GR-378

OWNER: Clarence Lysne

MAILING ADDRESS:

LOCATION OF WELL: Owner's No.


CITY AND STATE:

Silverton, Oregon

SE 1/4 SE 1/4 Sec. 26 T. 6 N. S, R. 1 E. W., W.M.

Bearing and distance from section or subdivision

corner 8 1/2 ch. W. & 1/2 ch. N. from SE Cor. Sec. 36

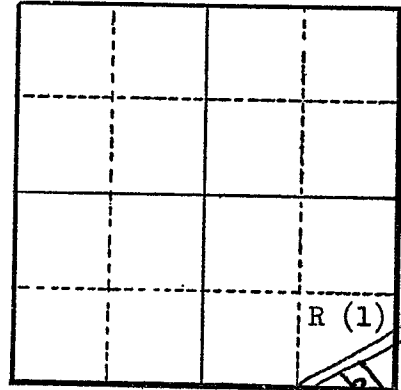

Section 26

Altitude at well 320

TYPE OF WELL: Drilled Date Constructed 1936

Depth drilled 140 Depth cased 30

CASING RECORD:

6 inch

FINISH:

AQUIFERS:

WATER LEVEL:

PUMPING EQUIPMENT: Type Pamona Turbine H.P. 5
Capacity 100 G.P.M.

WELL TESTS:

Drawdown ft. after hours G.P.M.
Drawdown ft. after hours G.P.M.

USE OF WATER Irrigation 21 acres Temp. °F. 19

SOURCE OF INFORMATION GR-378

DRILLER or DIGGER Johnson

ADDITIONAL DATA:

Log No. Water Level Measurements Chemical Analysis Aquifer Test

REMARKS: