

STATE ENGINEER
Salem, Oregon

Well Record

STATE WELL NO. 4/1W-70
COUNTY Marion ~~Clatsop~~
APPLICATION NO. GR-4107


MARI...345

OWNER: Walter E. Hisel MAILING ADDRESS: Route 2, Box 30 A

LOCATION OF WELL: Owner's No. CITY AND STATE: Aurora, Oregon

SW ¼ SE ¼ Sec. 7 T. 4 S., R. 1 W, W.M.

Bearing and distance from section or subdivision corner 627' E. of ¼ Cor. Between Sec. 7 & 18

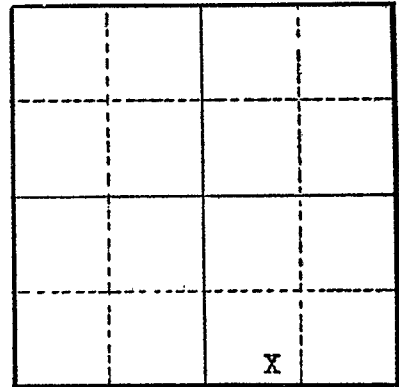

Altitude at well

TYPE OF WELL: Drilled Date Constructed 10/20/50

Depth drilled 93 ft. Depth cased 88 ft. 6 in.

Section 7

CASING RECORD:

6 inch casing set to 88 ft. 6 in.

FINISH:

AQUIFERS:

WATER LEVEL:

31 feet below surface

PUMPING EQUIPMENT: Type Robbins & Myers jet H.P. 2
Capacity G.P.M.

WELL TESTS:

Drawdown ft. after hours G.P.M.
Drawdown ft. after hours G.P.M.

USE OF WATER Irrigation Temp. °F., 19

SOURCE OF INFORMATION Well Registration Statement Cert. # GR-3693

DRILLER or DIGGER

ADDITIONAL DATA:
Log X Water Level Measurements Chemical Analysis Aquifer Test

REMARKS:

