

STATE ENGINEER
Salem, Oregon

MARI 3463

Well Record

STATE WELL NO. 6/1W-284
COUNTY MARION
~~APPLICATION NO.~~ GR-2503


OWNER: Robert Roth

MAILING ADDRESS: Rt. 2, Box 72

LOCATION OF WELL: Owner's No. _____
NE 1/4 NE 1/4 Sec. 28 T. 6 S., R. 1 W., W.M.

CITY AND STATE: Silverton, Oregon

Bearing and distance from section or subdivision corner 400' W. and 25' S.

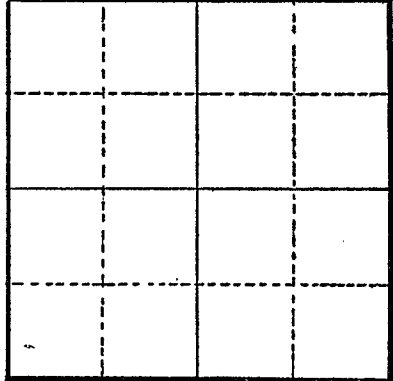

Section

Altitude at well _____

TYPE OF WELL: Drilled Date Constructed Unknown

Depth drilled 100 Depth cased 80

CASING RECORD:

8-inch

FINISH:

AQUIFERS:

WATER LEVEL:

20-feet

PUMPING EQUIPMENT: Type Peerless Turbine H.P. 5
Capacity 85 G.P.M.

WELL TESTS:

Drawdown Unknown ft. after _____ hours Pumping 85 G.P.M.
Drawdown _____ ft. after _____ hours _____ G.P.M.

USE OF WATER Irrigation Temp. _____ °F., 19

SOURCE OF INFORMATION GR-2370

DRILLER or DIGGER _____

ADDITIONAL DATA:

Log _____ Water Level Measurements _____ Chemical Analysis _____ Aquifer Test _____

REMARKS: