

STATE ENGINEER
Salem, Oregon

3474
MAR 1954

Well Record


STATE WELL NO. 6/1W-28L
COUNTY Marion
APPLICATION NO. GR-3369

OWNER: Gary Lee Espe
MAILING ADDRESS: Route 2, Box 64

LOCATION OF WELL: Owner's No. _____
CITY AND STATE: Silverton, Oregon

NE 1/4 SW 1/4 Sec. 28 T. 6 N. S., R. 1 E. W.M.

Bearing and distance from section or subdivision
corner 3740 feet North and 3370 feet East to
NE Corner, Section 28.

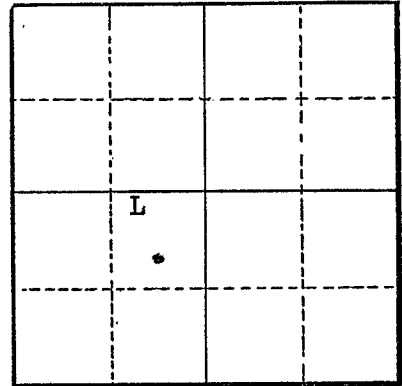

Section 28

Altitude at well _____

TYPE OF WELL: Drilled Date Constructed Spring 1954

Depth drilled 117 feet Depth cased _____

CASING RECORD:

FINISH:

AQUIFERS:

WATER LEVEL:

PUMPING EQUIPMENT: Type Turbine 5 horse H.P.
Capacity 90-100 G.P.M.

WELL TESTS:
Drawdown _____ ft. after _____ hours _____ G.P.M.
Drawdown _____ ft. after _____ hours _____ G.P.M.

USE OF WATER Irrigation Temp. _____ °F., 19

SOURCE OF INFORMATION GR-4124

DRILLER or DIGGER Stadelli Well Drilling, Silverton, Oregon

ADDITIONAL DATA:
Log (NA) Water Level Measurements _____ Chemical Analysis _____ Aquifer Test _____

REMARKS: