




Material	From	To
Top soil, Brown	0	3
Clay, brown	3	12
Clay, brown, silty	12	40
Clay, blue-green	40	49
Clay, dark gray	49	52
Clay, dark green med. sandy	52	58
Sand, fine black w/ some clay	58	61
Clay, rusty brown, fine sandy	61	64
Sand, brown, fine	64	72
Sand, black fine, medium cemented w/ some gravel	72	76
Clay, light brown	76	79
Clay, brown & sand cemented, brown	79	82
Clay, brown	82	91
Sand, brown, fine-medium	91	96
Gravel & sand, brown cemented	96	100
Clay, rusty brown	100	102
Clay, dark green	102	120
Sand, black medium w/ some pea gravel & wood	120	142
Sand, black, medium fine & gravel up to 3"	142	143
Sand, black, medium fine w/ wood	143	148
Clay, dark green, medium sandy	148	152
Sand, black, medium w/ wood	152	155
Sand & gravel, medium fine	155	157
Sand, black, fine	157	161
Gravel & sand, cemented	161	166
Gravel up to 4" w/ sand, coarse	166	185
Gravel & sand, coarse loose	185	205
Clay dark gray, flakey	205	208
Clay, green, hard	208	215
Clay, green, medium sandy	215	220
Clay, green, hard	220	225

RECEIVED

NOV 12 1980

WATER RESOURCES DEPT  
SALEM, OREGON

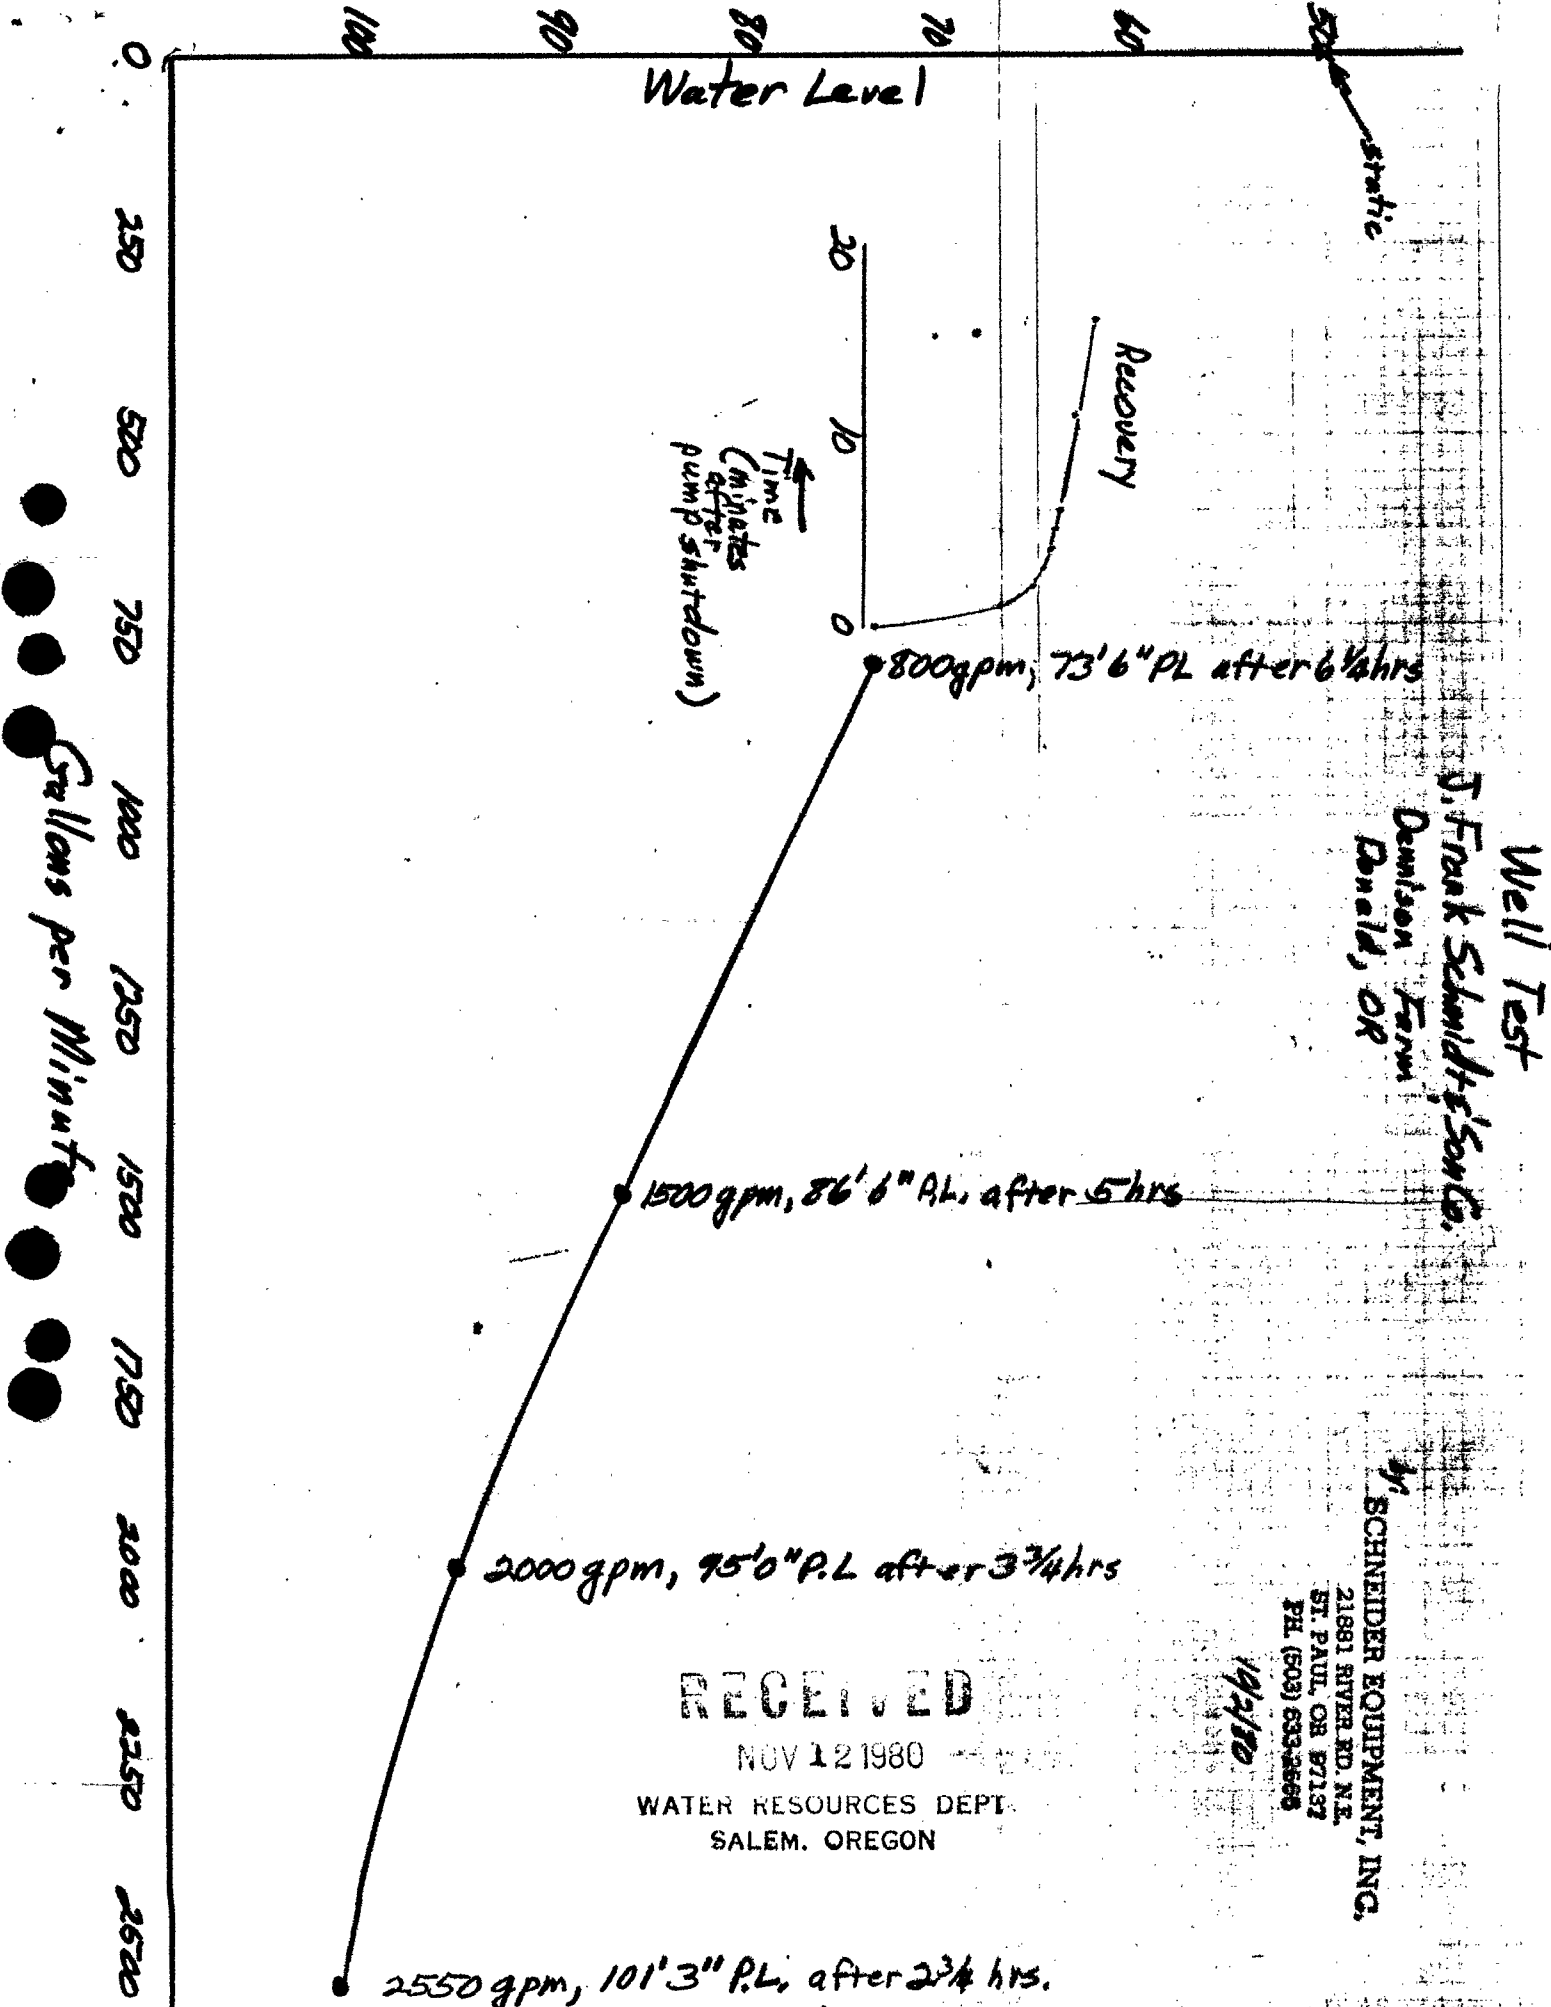

Gallons per Minute

0 250 500 750 1000 1250 1500 1750 2000 2250 2500

50 60 70 80 90 100

**Well Test**  
 J. Frank Schindler's Sons Co.  
 Denison Farm  
 Donald, OR

SCHNEIDER EQUIPMENT, INC.  
 21891 RIVER RD. N.E.  
 ST. PAUL, OR 97137  
 PH. (503) 633-2666

RECEIVED

NOV 12 1980

WATER RESOURCES DEPT.  
 SALEM, OREGON

11/2/80