

STATE ENGINEER
Salem, Oregon

MA 3498 Well Record


STATE WELL NO. 6/LW-29R(1)
COUNTY Marion
APPLICATION NO. GR-28

OWNER: Archie R. and Elsie E. Eberhardt MAILING ADDRESS: _____

LOCATION OF WELL: Owner's No. #1 CITY AND STATE: Silverton, Oregon

SE 1/4 SE 1/4 Sec. 29 T. 6 N. S. R. 1 E. W.M.

Bearing and distance from section or subdivision
corner 510' N. & 260' W. of SE Cor. Sec. 29

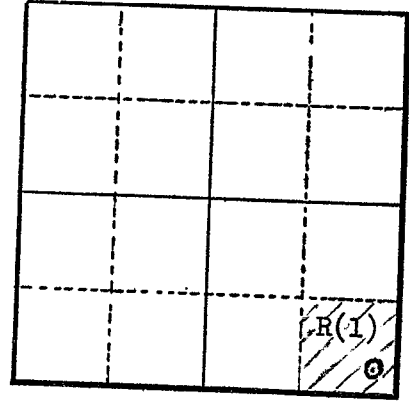

Section 29

Altitude at well 249' Interpolator

TYPE OF WELL: Drilled Date Constructed 1946

Depth drilled 190' Depth cased 188'

CASING RECORD:

8" casing set from 0 to 188'

FINISH:

Perforations set at 56 to 77', 91' to 99', and 121' to 128'

AQUIFERS:

Gravels from 60 to 118' and from 147 to 193'

WATER LEVEL:

Not Known

PUMPING EQUIPMENT: Type Peerless Turbine 4" Capacity 140 G.P.M. H.P. _____

WELL TESTS: No Tests
Drawdown _____ ft. after _____ hours _____ G.P.M.
Drawdown _____ ft. after _____ hours _____ G.P.M.

USE OF WATER Domestic & Irrigation 40 ac. Temp. _____ °F. _____, 19
SOURCE OF INFORMATION Registration Statement GR-28

DRILLER or DIGGER _____

ADDITIONAL DATA:
Log Water Level Measurements _____ Chemical Analysis _____ Aquifer Test _____

REMARKS:

STATE ENGINEER
Salem, Oregon

Well Log

State Well No. 6/1W-29R(1)
 County Marion
 Application No. GR-28

Owner: Archie R. Eberhardt

Owner's No. 1

Driller: _____ Date Drilled 1947

CHARACTER OF MATERIAL	(Feet below land surface)		Thickness (feet)
	From	To	
Clay	0	40	40
Gravel, hard (water at 121')	40	60	20
Gravel, loose (water at 65')	60	65	5
Gravel, hard (water at 80')	65	80	15
Gravel, loose	80	90	10
Gravel, hard	90	100	10
Gravel, loose	100	110	10
Rock	110	114	4
Sand, loose and coarse (water at 118')	114	118	4
Gravel, dirty, loose	118	128	10
Sand, dirty	128	147	19
(not logged) water at 185 ft.	147	190	43