
STATE OF OREGON

WATER WELL REPORT (as required by ORS 537.765)

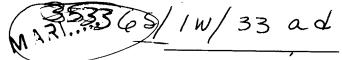



Name	
City State 2 Zip 92381 Section 33 S.E 4 N.E 4	
Section 33 J.E 1/4 /V.E 1/4	
New Well Deepen Recondition Abandon Street Address of Well (or nearest address) 12353 Shark For	7/
(3) DRILL METHOD Silverton Organ.	4
Rotary Air	_
Other ft. below land surface. Date Lune 18,1	152
(4) PROPOSED USE: Artesian pressure lb. per square inch. Date	
Community Industrial Irrigation Injection Other (11) WATER BEARING ZONES:	_
(5) BORE HOLE CONSTRUCTION: Depth at which water was first found	
Special Construction approval Yes No Depth of Completed Well ft. From To Estimated Flow Rate SWI	ī.
Yes No La Cardual increase and and	_
Elosives used Type Amount Amount	_
HOLE SEAL Amount	
Diameter From To Material From To sacks or pounds 12 0 84 Conv. N. 0 24 20	
70 24 5 (12) WELLLOG:	_
Ground elevation	
Material From To SWI	Լ
How was seal placed: Method	
Other	
Backfill placed fromft. toft. Material	
Gravel placed fromft. toft. Size of gravel	
16 120	
(6) CASING/LINER: Fack Honeycomb. 120 124	
Casing: B + 1 B + 23D	
Lacer Amendam b. 160 124	
- $ -$	
Took Honeyson 123 200	
1000 Ver Mars 200 245 49	<u> </u>
Final location of shoe(s)	
') PERFORATIONS/SCREENS:	_
Perforations Method	
✓ Screens Type Material	
Slot Tele/pipe	╝
From To size Number Diameter size Casing Liner	╝
	╝
	_
	╝
Date started June. 9, 1988. Completed June 19, 1888	<u>,</u>
(mah and al) Washan 197-11 C	_
I certify that the work I performed on the construction, alteration, of	or
Pump Bailer Air Artesian abandonment of this well is in compliance with Oregon well construction standards. Materials used and information reported above are true to my bear the standards.	on
Yield gal/min Drawdown Drill stem at Time knowledge and belief.	st
/250. 243. 4 thr. WWC Number	
Signed Date	_
	=
Constructor Certification:	
work performed on this well during the construction dates reported above, a	all:
work performed during this time is in compliance with Oregon we	all.
Did any strata contain water not suitable for intended use? Too little	ıd
Salty Muddy Odor Colored Other belief. WWC Number 25	_