

STATE ENGINEER
Salem, Oregon

MARI 359 Well Record

STATE WELL NO. 4/W - 8A1
COUNTY MARION
APPLICATION NO. GR-1999

OWNER: Ralph Racette


MAILING ADDRESS: Rt. 2, Box 177

LOCATION OF WELL: Owner's No. _____

CITY AND STATE: Aurora, Oregon

NE $\frac{1}{4}$ NE $\frac{1}{4}$ Sec. 8 T. 4 N. S., R. 1 E. W., W.M.

Bearing and distance from section or subdivision corner 462' S. & 158' W.

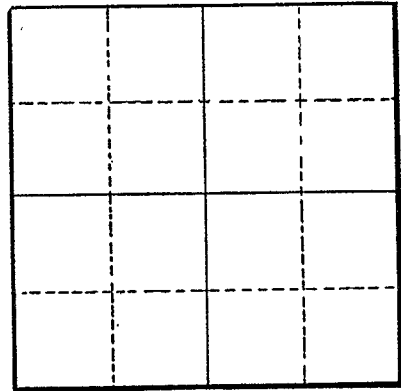

Altitude at well _____

TYPE OF WELL: Drilled Date Constructed 1949

Depth drilled 110 Depth cased 86

Section _____

CASING RECORD:

8-inch

FINISH:

Perforation from 52 to 54

AQUIFERS:

Clay

WATER LEVEL:

PUMPING EQUIPMENT: Type Peerless Turbine H.P. 15
Capacity 260 G.P.M.

WELL TESTS:

Drawdown _____ ft. after _____ hours _____ G.P.M.
Drawdown _____ ft. after _____ hours _____ G.P.M.

USE OF WATER Irrigation - 38 acres Temp. _____ °F. _____, 19_____

SOURCE OF INFORMATION GR-1929

DRILLER or DIGGER Roy Perkins Rt. 2, Box 315, Salem, Oregon

ADDITIONAL DATA:
Log Water Level Measurements _____ Chemical Analysis _____ Aquifer Test _____

REMARKS:

