

STATE ENGINEER
Salem, Oregon

3692 Well Record
MIRI.....


STATE WELL NO. 6/1W-36K
COUNTY Marion
APPLICATION NO. GR-2067

OWNER: William E. Gibson MAILING ADDRESS: Rt. 1, Box 155

LOCATION OF WELL: Owner's No. CITY AND STATE: Silverton, Oregon

N E
NW 1/4 SE 1/4 Sec. 36 T. 6 S., R. 1 W., W.M.

Bearing and distance from section or subdivision corner 1700' W. & 1600' N.

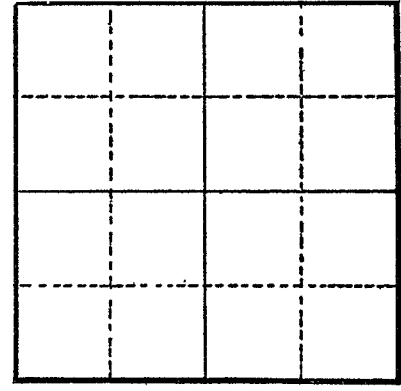

Section 36

Altitude at well _____

TYPE OF WELL: Drilled Date Constructed 1953

Depth drilled 200' Depth cased 60'

CASING RECORD:
8"

FINISH:

AQUIFERS:

WATER LEVEL:

PUMPING EQUIPMENT: Type Jacuzzi Jet H.P. 3
Capacity 24 G.P.M.

WELL TESTS:
Drawdown _____ ft. after _____ hours _____ G.P.M.
Drawdown _____ ft. after _____ hours _____ G.P.M.

USE OF WATER Irrigation Temp. _____ °F., 19 _____

SOURCE OF INFORMATION GR-1989

DRILLER or DIGGER R. Stadeli

ADDITIONAL DATA:
Log _____ Water Level Measurements _____ Chemical Analysis _____ Aquifer Test _____

REMARKS: