

STATE ENGINEER
Salem, Oregon

Well Record

STATE WELL NO. ⁷ 8/2W-1A
COUNTY Marion
APPLICATION NO. GR-3116

3703
MARI...03

OWNER: Clarence D. Herr

MAILING ADDRESS:

Route 2, Box 188


LOCATION OF WELL: Owner's No.

CITY AND STATE:

Silverton, Oregon

NE 1/4 NE 1/4 Sec. 1 T. 6 S., R. 2 W., W.M.

Bearing and distance from section or subdivision corner 250' N. and 470' W.

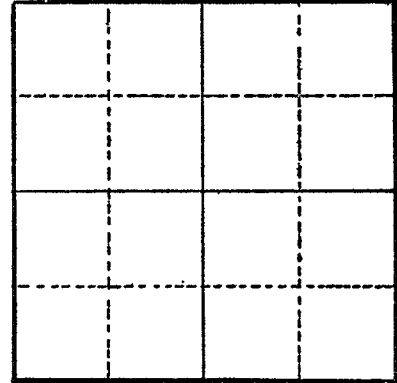

Section

Altitude at well

TYPE OF WELL: Drilled Date Constructed 1949

Depth drilled 131' Depth cased 131'

CASING RECORD:

10"

FINISH:

AQUIFERS:

WATER LEVEL:

60'

PUMPING EQUIPMENT: Type Fairbanks Morse Turbine H.P. 25
Capacity 300 G.P.M.

WELL TESTS:

Drawdown 105' ft. after hours pumping 300 G.P.M.
Drawdown ft. after hours G.P.M.

USE OF WATER Irrigation Temp. °F., 19

SOURCE OF INFORMATION GR-2924

DRILLER or DIGGER Sneed and Sons Salem, Oregon

ADDITIONAL DATA:

Log Water Level Measurements Chemical Analysis Aquifer Test

REMARKS: