

STATE ENGINEER
Salem, Oregon

MARI 3706
MARI 3706

Well Record

GR-1042

STATE WELL NO. 6/2W-1E(1)
COUNTY Marion
APPLICATION NO. GR-1080

OWNER: Valentine Miller


MAILING ADDRESS: Rt. 1, Box 87

LOCATION OF WELL: Owner's No.

CITY AND STATE: Brooks, Oregon

SW 1/4 NW 1/4 Sec. 1 T. 6 S., R. 2 W., W.M.

Bearing and distance from section or subdivision corner 950' E. & 1760' S. from NW cor. Sec. 1

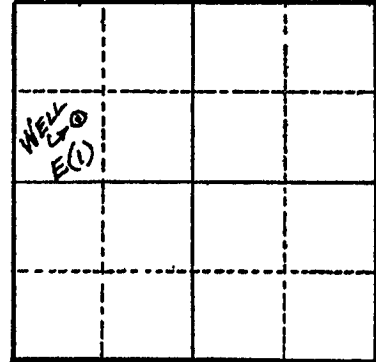

Section 1

Altitude at well 175 ft.

TYPE OF WELL: Drilled Date Constructed 1955

Depth drilled 156 ft. Depth cased 156 ft.

CASING RECORD:

12 inch

FINISH:

168 Mills perforations from 108 to 120 ft.
132 " " " " 150 to 156 ft.

AQUIFERS:

Sand and gravel from 106 to 120
" " " " 149 to 156

WATER LEVEL:

18 ft.

PUMPING EQUIPMENT: Type Jacuzzi Inlineshaft Turbine H.P. 20
Capacity 350 G.P.M.

WELL TESTS:

Drawdown 29 ft. after _____ hours 640 G.P.M.
Drawdown _____ ft. after _____ hours _____ G.P.M.

USE OF WATER Irrigation Temp. _____ °F. _____, 19

SOURCE OF INFORMATION G.R. Record

DRILLER or DIGGER Willamette Drilling Co.

ADDITIONAL DATA:

Log Water Level Measurements _____ Chemical Analysis _____ Aquifer Test _____

REMARKS:

Irrigation of 99.7 acres.

WELL IDENTIFICATION APPLICATION FORM

RECEIVED

BUYER/CURRENT WELL OWNER:

NOV 21 1996

Name: Valentine & Dolores A. Miller

WATER RESOURCES DEPT.
SALEM, OREGON

Mailing Address: 8626 Wabash Dr. NE

City: Brooks State: Or Zip: 97305 Phone: 503 792-3380

WELL LOCATION:

MARI 3706

County: Marion Township: 6S or S, Range: 2 or W

Section: I SW 1/4 NW 1/4 Owner's Well Number: South

Tax Lot Number: 00300 Street Address of Well (if different from above): _____

WELL INFORMATION: (do not complete remainder of application if well log is available)

Start Card Number: ~~_____~~ Approx. Construction Date: Feb completed April 1955

Well Constructor: Willamette Drilling Co.

Name of Owner at Time of Construction: Valentine & Dorothy Miller

Well Depth (in feet): 156 Static Water Level (in feet): 46

Diameter of Exposed Well Casing (in inches): 12 inch

Does this well have a formal water right associated with it? Yes: No: _____

If Yes: Application #: 1080 Permit #: GR1042 Certificate #: GR1042

Please Return Completed Form to:

Lisa Juul
Well Identification Program
Oregon Water Resources Department
158 12th Street NE
Salem, OR 97310

For Official Use Only:
Well Tag No. 12324