

STATE ENGINEER
Salem, Oregon

MARI. 3733

Well Record

STATE WELL NO. 6/2W-2E(1)
COUNTY Marion
APPLICATION NO. GR-2069

OWNER: Irwin J. and Dora Koenig


MAILING ADDRESS: Rt. 1, Box 83

LOCATION OF WELL: Owner's No.

CITY AND STATE: Brooks, Oregon

SW 1/4 NW 1/4 Sec. 2 T. 6 N. S., R. 2 W., W.M.

Bearing and distance from section or subdivision corner 1550' S & 1250' E.

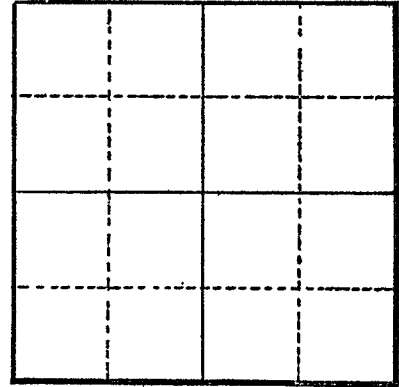

Section 2

Altitude at well 182'

TYPE OF WELL: Bored Date Constructed 1954

Depth drilled 65' Depth cased 65'

CASING RECORD:
12"

FINISH:

12" concrete tile to 65'
Gravel packed from bottom up to 18'
Top to 18' cement grouted.

AQUIFERS:

Clay-sand

WATER LEVEL:

26'

PUMPING EQUIPMENT: Type Sears Jet H.P. 3
Capacity 115 G.P.M.

WELL TESTS:

Drawdown ft. after hours G.P.M.
Drawdown ft. after hours G.P.M.

USE OF WATER Irrigation 20 acres Temp. °F., 19

SOURCE OF INFORMATION GR-1991

DRILLER or DIGGER Willamette Drilling Co., Rt. 2, Box 333, Salem, Oregon

ADDITIONAL DATA:

Log Water Level Measurements Chemical Analysis Aquifer Test

REMARKS:

Top soil Top to 3'
Yellow silty clay 3 to 26'
Blue clay 26' to 65'
Black sand 65' to ?