

STATE ENGINEER
Salem, Oregon

3734
MARI.....

Well Record


STATE WELL NO. 6/2W-Ze(2)
COUNTY Marion
APPLICATION NO. GR-930

OWNER: Herman G. Hahn MAILING ADDRESS: Rt. 2, Box 287

LOCATION OF WELL: Owner's No. #1 CITY AND STATE: Salem, Oregon

SW 1/4 NW 1/4 Sec. 2 T. 6 N. S., R. 2 W., W.M.

Bearing and distance from section or subdivision corner 1950' S. & 50' E. from NW Cor. Sec. 2

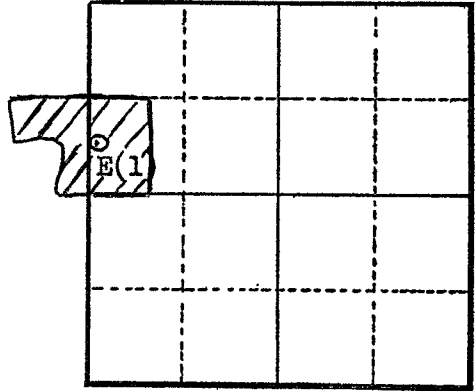

Section 9

Altitude at well 178'

TYPE OF WELL Drilled Date Constructed May, 1955

Depth drilled 166' Depth cased 136'

CASING RECORD:

10" standard black pipe 0'-136'

FINISH:

17 rows of 10 cuts per row
total 170 cuts. Mills knife 118'-135'

AQUIFERS:

Black sand 64'-78' water
Black sand & gravel 114'-126' water

WATER LEVEL:

22'

PUMPING EQUIPMENT: Type Fairbanks Morse Turbine H.P. 20
Capacity 350 G.P.M.

WELL TESTS:

Drawdown 100 ft. after _____ hours _____ G.P.M.
Drawdown 69 ft. after _____ hours _____ G.P.M.

USE OF WATER Irrigation 50 acres Temp. _____ °F., 19

SOURCE OF INFORMATION Owner

DRILLER or DIGGER _____

ADDITIONAL DATA:

Log X Water Level Measurements _____ Chemical Analysis _____ Aquifer Test _____

REMARKS:

