

MARI 3799

OBSERVATION WELL

STATE ENGINEER
Salem, Oregon

MARI 3799

Well Record

STATE WELL NO. 6/2W-5N(1)
COUNTY Marion
APPLICATION NO.

OWNER: Fred Zelinsky

MAILING ADDRESS:

LOCATION OF WELL: Owner's No.

CITY AND STATE:

SE 1/4 SW 1/4 Sec. 5 T. 6 N. S, R. 2 W., W.M.


Bearing and distance from section or subdivision

corner 1900' E. & 350' N. from SW Cor.

Altitude at well 170'

TYPE OF WELL: Drilled Date Constructed 1922

Depth drilled 115' Depth cased 123'

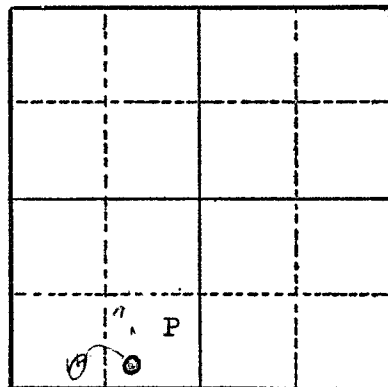

Section 5

CASING RECORD:

8"

FINISH:

AQUIFERS:

Gravel

WATER LEVEL:

13.45 (1-18-60) 0.40' below land surface 5/30/57

PUMPING EQUIPMENT: Type None Inst.

H.P.

Capacity G.P.M.

WELL TESTS: 5

Drawdown ft. after hours G.P.M.

Drawdown ft. after hours G.P.M.

USE OF WATER None

Temp. °F., 19

SOURCE OF INFORMATION Field Visit

DRILLER or DIGGER

ADDITIONAL DATA:

Log X Water Level Measurements Chemical Analysis Aquifer Test

REMARKS:

Top Soil 0-6
Hard Pan 6-9
Clay 9-23
Hardpan, Boulders & clay 23-35
Sand & gravel, some water 35-40
Clay, blue (fir log at 92') 74-114
Gravel, very little sand 114-123

Well 299 in water-supply paper
890'-original depth 123'

Water Level Record

OWNER: Fred Zelinsky OWNER'S NO. _____

Description of measuring point: Top of casing 0.1 feet above L.S.D. which
is 8" casing set in concrete slab at pump house

Date	Water Level Feet (above) (below) Land Surface	Remarks	Date	Water Level Feet (above) (below) Land Surface	Remarks
5/30/57	9.40	WSB (No Pump) inst.			
10/15/57	16.90	WSB.			
6-11-58	11.11	WSB.			
12-16-58	12.10	WSB.			
5-6-59	8.72	WSB			
11-30-59	17.18	WSB			
6-6-60	7.30	WSB			
11-7-60	—	(No Key) WSB, USGS Recorder Inst.			
3-30-61	5.72	WSB			

REMARKS: Irrig. Well.
