

STATE ENGINEER
Salem, Oregon

3852
MARI.....

Well Record

STATE WELL NO. 6/2w-7P
COUNTY Marion
APPLICATION NO. GR-2075

OWNER: Elmer E. Jacobsen


MAILING ADDRESS: Route 1

LOCATION OF WELL: Owner's No.

CITY AND STATE: Brooks, Oregon

SE 1/4 SW 1/4 Sec. T. 6 N. S., R. 2 W., W.M.

Bearing and distance from section or subdivision
corner 1200' W. & 290' N.

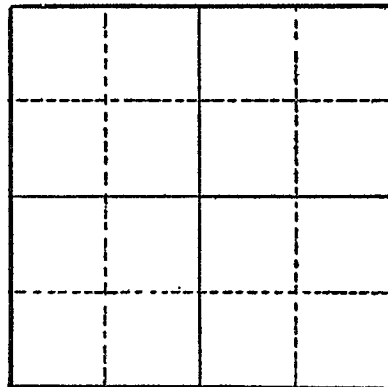

Section 7

Altitude at well

TYPE OF WELL: Drilled Date Constructed 1943

Depth drilled 105' Depth cased 105'

CASING RECORD:

6"

FINISH:

Perforations from 84 to 104

AQUIFERS:

WATER LEVEL:

30'

PUMPING EQUIPMENT: Type Meyers Jet H.P. 2
Capacity 20 G.P.M.

WELL TESTS:

Drawdown ft. after hours G.P.M.

Drawdown ft. after hours G.P.M.

USE OF WATER Irrigation Temp. °F., 19

SOURCE OF INFORMATION GR-1994

DRILLER or DIGGER

ADDITIONAL DATA:

Log Water Level Measurements Chemical Analysis Aquifer Test

REMARKS: