

STATE ENGINEER
Salem, Oregon

3900
MARI.....

Well Record


STATE WELL NO. 6/2W-9M(1)
COUNTY Marion
APPLICATION NO. GR-528

OWNER: Stanley Sneed
MAILING ADDRESS: Rt. 1, Box 73

LOCATION OF WELL: Owner's No. _____
CITY AND STATE: Brooks, Oregon

N. E.
NW 1/4 SW 1/4 Sec. 9 T. 6 S., R. 2 W., W.M.

Bearing and distance from section or subdivision
corner 800' E., 500' S. from W. 1/4 Cor. Sec. 9

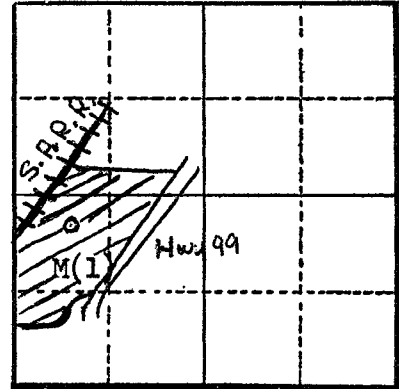

Altitude at well 180'

TYPE OF WELL: drilled Date Constructed Aug. 9, 1954

Depth drilled 130' Depth cased 125'

Section 9

CASING RECORD:

10"

FINISH:

Casing perforated 88 to 92, 103 to 122

AQUIFERS:

Cemented gravel from 86 to 92

Gravel from 102 1/2 to 121

WATER LEVEL:

13'

PUMPING EQUIPMENT: Type Jacuzzi Turbine H.P. 30

Capacity 500 G.P.M.

WELL TESTS:

Drawdown 36 ft. after _____ hours G.P.M.

Drawdown _____ ft. after _____ hours G.P.M.

USE OF WATER Irrigation 58 Acres Temp. _____ °F., 19

SOURCE OF INFORMATION GR-528

DRILLER or DIGGER _____

ADDITIONAL DATA:

Log Water Level Measurements _____ Chemical Analysis _____ Aquifer Test _____

REMARKS:

