

STATE ENGINEER
Salem, Oregon

3902
MAR 1955

Well Record

STATE WELL NO. 6/2W-9N
COUNTY Marion
APPLICATION NO. GR-2656

OWNER: Lawrence M. Wolfe


MAILING ADDRESS: Route 1, Box 72 Pg 1 of 2

LOCATION OF WELL: Owner's No.

CITY AND STATE: Brooks, Oregon

SW 1/4 SW 1/4 Sec. 9 T. 6 S., R. 2 W., W.M.

Bearing and distance from section or subdivision corner 9.3 chs. N. & 15.8 chs. E.

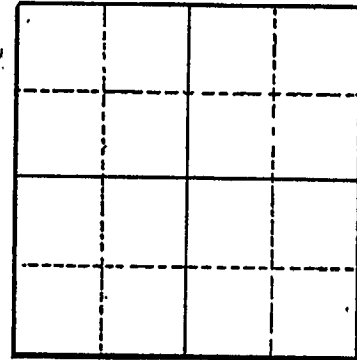

Section

Altitude at well

TYPE OF WELL: Date Constructed 1955

Depth drilled 100' Depth cased 100'

CASING RECORD:

6 inch

FINISH:

AQUIFERS:

sand, gravel and rock

WATER LEVEL:

9 feet

PUMPING EQUIPMENT: Type Fairbanks Morse Jet H.P. 3
Capacity 90 G.P.M.

WELL TESTS:

Drawdown ft. after hours G.P.M.

Drawdown ft. after hours G.P.M.

USE OF WATER irrigation Temp. °F. 19

SOURCE OF INFORMATION GR-2518

DRILLER or DIGGER Wymore

ADDITIONAL DATA:

Log X Water Level Measurements Chemical Analysis Aquifer Test

REMARKS:

Sand and Gravel 0 to 95
Rock 95 to 100

STATE ENGINEER
Salem, Oregon

3902
MARI...02

Well Record

STATE WELL NO. 6/2W-9N(1)
COUNTY Marion
APPLICATION NO.

OWNER: L. M. Wolf


MAILING ADDRESS: 9 20f2

LOCATION OF WELL: Owner's No.

CITY AND STATE:

1/4 1/4 Sec. T. N. S, R. E. W., W.M.

Bearing and distance from section or subdivision corner

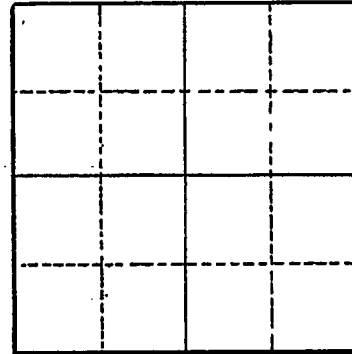

Altitude at well 175

TYPE OF WELL: Drilled Date-Constructed 1955

Depth drilled 100 Depth cased

Section

CASING RECORD:

6 inch

FINISH:

Open bottom, casing unperforated

AQUIFERS:

"Rock" from 95 to 100

WATER LEVEL:

9 feet

PUMPING EQUIPMENT: Type Jet H.P. 1
Capacity G.P.M.

WELL TESTS:

Drawdown ft. after hours G.P.M.
Drawdown ft. after hours G.P.M.

USE OF WATER Irrigation--13.5 acres Temp. °F., 19

SOURCE OF INFORMATION USGS

DRILLER or DIGGER

ADDITIONAL DATA:

Log Water Level Measurements Chemical Analysis Aquifer Test

REMARKS:

Sand and gravel to 95 feet; "rock" to 100 feet.