

STATE ENGINEER
Salem, Oregon

MARI 393

Well Record

STATE WELL NO. 4/1W-9R(1)
COUNTY Marion
APPLICATION NO. GR-1087

GR- 1048

OWNER: Lucille M. Strange


MAILING ADDRESS: Rt. 1, Box 27

LOCATION OF WELL: Owner's No.

CITY AND STATE: Aurora, Oregon

SE 1/4 SE 1/4 Sec. 9 T. 4 S., R. 1 W., W.M.

Bearing and distance from section or subdivision corner 600' W. & 440' N. from SE cor. Sec. 9.

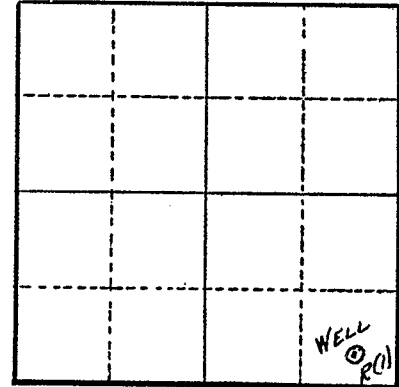

Section 9

Altitude at well 180 ft.

TYPE OF WELL: Drilled Date Constructed 1954

Depth drilled 75 ft. Depth cased 71 ft.

CASING RECORD:

8 inch

FINISH:

AQUIFERS:

WATER LEVEL:

PUMPING EQUIPMENT: Type F. M. turbine H.P. 5
Capacity 100 G.P.M.

WELL TESTS:

Drawdown ft. after hours G.P.M.
Drawdown ft. after hours G.P.M.

USE OF WATER Irrigation Temp. °F. 19

SOURCE OF INFORMATION G. R. Record

DRILLER or DIGGER J. T. Miller

ADDITIONAL DATA:

Log Water Level Measurements Chemical Analysis Aquifer Test

REMARKS:

Log: Top soil	0 to 3 ft.
Yellow clay	3 to 31 ft.
Sand clay (water)	31 to 63 ft.
Blue clay	63 to 64 ft.
Broken sand & gravel	64 to 71 ft.
Coarse sand & gravel	71 to 75 ft.

Irrigation of 15 acres.