

STATE ENGINEER
Salem, Oregon

MART. 3954

Well Record

STATE WELL NO. 6/2W-11M(1)
COUNTY Marion
APPLICATION NO. GR-1082

GR- 1044

OWNER: Myron S. Harper


MAILING ADDRESS: Rt. 1, Box 161A

LOCATION OF WELL: Owner's No.

CITY AND STATE: Brooks, Oregon

NW 1/4 SW 1/4 Sec. 11 T. 6 S., R. 2 W., W.M.

Bearing and distance from section or subdivision corner 1605' N. 21° 30' E. from the SW cor. SEC. 11.

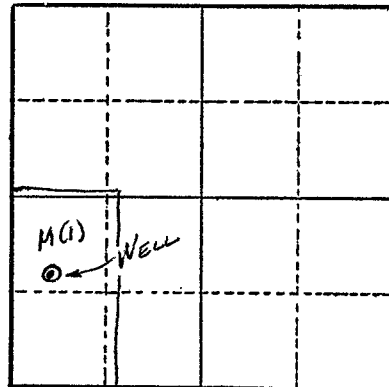

Section 11

Altitude at well 150 ft. 170

TYPE OF WELL: Drilled Date Constructed 1954

Depth drilled 145 ft. Depth cased 145 ft.

CASING RECORD:
12 inch.

FINISH:

11 perforations per foot (3/8 x 2 in.) from 90 to 116 ft.
" " " " " " " " " 138 to 145 ft.

AQUIFERS:

WATER LEVEL:

28 ft.

PUMPING EQUIPMENT: Type Western Land Roller turbine H.P. 40
Capacity 600 G.P.M.

WELL TESTS:

Drawdown	30	ft. after	hours	400	G.P.M.
Drawdown	37	ft. after	hours	600	G.P.M.

USE OF WATER Irrigation Temp. °F. 19

SOURCE OF INFORMATION G.R. Record

DRILLER or DIGGER Wymore

ADDITIONAL DATA:

Log Water Level Measurements Chemical Analysis Aquifer Test

REMARKS:

Irrigation of 150.3 acres.
Not used in 1960.

