

STATE ENGINEER **MAR 3973** Well Record
Salem, Oregon

STATE WELL NO. 6/2W-12L
COUNTY Marion
APPLICATION NO. GR-3268

OWNER: Willis M. Bartlett


MAILING ADDRESS: Brooks g 10f2

LOCATION OF WELL: Owner's No. _____

CITY AND STATE: Oregon

NE 1/4 SW 1/4 Sec. 12 T. 6 N. S. R. 2 E. W., W.M.

Bearing and distance from section or subdivision corner 410' W. & 460' S. from NW cor. of NE 1/4 SW 1/4

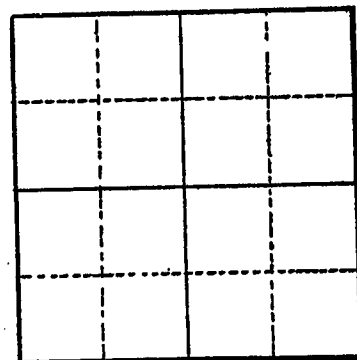

Section _____

Altitude at well _____

TYPE OF WELL: drilled Date Constructed 1938

Depth drilled 620 Depth cased _____

CASING RECORD:

FINISH:

AQUIFERS:

WATER LEVEL:

PUMPING EQUIPMENT: Type Turbine pump H.P. 20
Capacity 1000 G.P.M.

WELL TESTS:
Drawdown _____ ft. after _____ hours _____ G.P.M.
Drawdown _____ ft. after _____ hours _____ G.P.M.

USE OF WATER Irrigation Temp. _____ °F. _____, 19____

SOURCE OF INFORMATION GR-3040
DRILLER or DIGGER _____

ADDITIONAL DATA:
Log _____ Water Level Measurements _____ Chemical Analysis _____ Aquifer Test _____

REMARKS:

STATE ENGINEER
Salem, Oregon

3973
MAR 1938

Well Record

STATE WELL NO. 6/2W-12L(1)
COUNTY Marion
APPLICATION NO. _____

g 2 of 2

OWNER: W. M. Bartlett

MAILING ADDRESS: _____

LOCATION OF WELL: Owner's No. _____

CITY AND STATE: _____

..... $\frac{1}{4}$ $\frac{1}{4}$ Sec. T. N. E. S., R. W., W.M.

Bearing and distance from section or subdivision corner _____

Altitude at well 150

TYPE OF WELL: Drilled Date Constructed 1938

Depth drilled 620 Depth cased _____

Section _____

CASING RECORD:

8 inch

FINISH:

AQUIFERS:

WATER LEVEL:

PUMPING EQUIPMENT: Type Turbine H.P. 20
Capacity _____ G.P.M.

WELL TESTS:

Drawdown _____ ft. after _____ hours _____ G.P.M.
Drawdown _____ ft. after _____ hours _____ G.P.M.

USE OF WATER Irrigation--23 acres Temp. _____ °F. _____, 19____

SOURCE OF INFORMATION USGS

DRILLER or DIGGER _____

ADDITIONAL DATA:

Log _____ Water Level Measurements _____ Chemical Analysis _____ Aquifer Test _____

REMARKS: