

STATE ENGINEER
Salem, Oregon

3977
MARI....

Well Record

GR-934


STATE WELL NO. 6/2W-12B
COUNTY Marion
APPLICATION NO. GR-963

OWNER: Henry G. Stockhoff
MAILING ADDRESS:

LOCATION OF WELL: Owner's No. CITY AND STATE: Brooks, Oregon

NW 1/4 NE 1/4 Sec. 12 T. 6 S., R. 2 W., W.M.

Bearing and distance from section or subdivision corner 2175' W. & 500' S. of NE cor. Sec. 12.

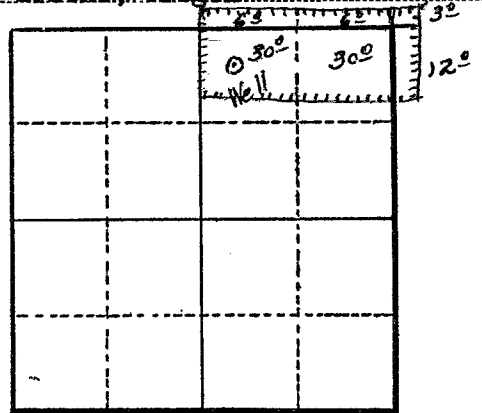

Section 12

Altitude at well 157 ft.

TYPE OF WELL: Drilled Date Constructed 1953

Depth drilled 142 ft. Depth cased 142 ft.

CASING RECORD:

10 inch

FINISH:

Perforated from 127 to 142 ft.

AQUIFERS:

WATER LEVEL:

25 ft.

PUMPING EQUIPMENT: Type Johnson Turbine H.P. 30
Capacity 400 G.P.M.

WELL TESTS:

Drawdown 88 ft. after 350 hours G.P.M.
Drawdown 79 ft. after 300 hours G.P.M.

USE OF WATER Irrigation Temp. °F., 19.

SOURCE OF INFORMATION G.R. Record

DRILLER or DIGGER Irving Sears

ADDITIONAL DATA:

Log Water Level Measurements Chemical Analysis Aquifer Test

REMARKS:

Irrigation of 87 acres.