

STATE ENGINEER
Salem, Oregon

3978
MARI.....

Well Record

GR- 1418

STATE WELL NO. 6/2W-12E
COUNTY Marion
APPLICATION NO. GR-1469

OWNER: Martin Schlechter


MAILING ADDRESS: Rt. 1, Box 142

LOCATION OF WELL: Owner's No.

CITY AND STATE: Brooks, Oregon

SW ^{XX} 1/4 NW ^{XX} 1/4 Sec. 12 T. 6 S., R. 2 W., W.M.

Bearing and distance from section or subdivision corner 2200' S. & 700' E. from NW cor. Sec. 12

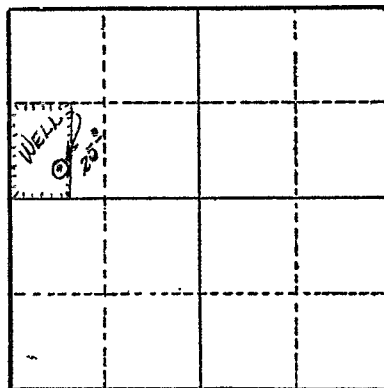

Section 12

Altitude at well

TYPE OF WELL: Drilled Date Constructed 1950

Depth drilled 151' Depth cased 151'

CASING RECORD:
7" OD

FINISH:

AQUIFERS:

WATER LEVEL:

PUMPING EQUIPMENT: Type F. M. H.P. 5
Capacity 100 G.P.M.

WELL TESTS:
Drawdown 20 ft. after hours 100 G.P.M.
Drawdown ft. after hours G.P.M.

USE OF WATER Irrigation Temp. °F. 19

SOURCE OF INFORMATION GR Record

DRILLER or DIGGER

ADDITIONAL DATA:
Log ^X Water Level Measurements Chemical Analysis Aquifer Test

REMARKS:

Irrigation of 25 acres

