

STATE ENGINEER  
Salem, Oregon

3979  
MAR 1979

# Well Record


STATE WELL NO. 6/2W-12F  
COUNTY Marion  
APPLICATION NO. GR-1574

OWNER: John W. and Anna G. Eggers  
MAILING ADDRESS: Rt. 1, Box 150

CITY AND STATE: Brooks, Oregon

LOCATION OF WELL: Owner's No. \_\_\_\_\_  
SE. 1/4 NW 1/4 Sec. 12 T. 6 N. S. R. 2 W., W.M.

Bearing and distance from section or subdivision  
corner 185' W. & 90' N.

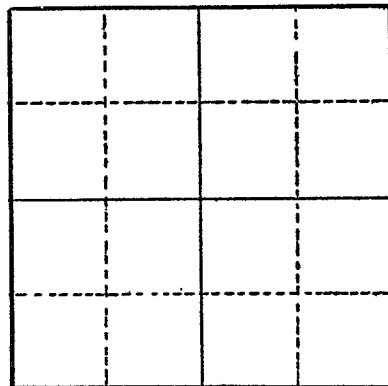

Section 12

Altitude at well \_\_\_\_\_

TYPE OF WELL Drilled Date Constructed 1951

Depth drilled 142 Depth cased 142

### CASING RECORD:

6 "

### FINISH:

### AQUIFERS:

Clay and sand

### WATER LEVEL:

15'

PUMPING EQUIPMENT: Type Flint & walling (Jet) H.P. 3  
Capacity 40 G.P.M.

### WELL TESTS:

Drawdown \_\_\_\_\_ ft. after \_\_\_\_\_ hours \_\_\_\_\_ G.P.M.  
Drawdown \_\_\_\_\_ ft. after \_\_\_\_\_ hours \_\_\_\_\_ G.P.M.

USE OF WATER Irrigation Temp. \_\_\_\_\_ °F., 19

SOURCE OF INFORMATION GR-2020

DRILLER or DIGGER Wymore Well Drillers, Rt. 2, Salem, Oregon

### ADDITIONAL DATA:

Log  Water Level Measurements \_\_\_\_\_ Chemical Analysis \_\_\_\_\_ Aquifer Test \_\_\_\_\_

### REMARKS:

