

STATE ENGINEER
Salem, Oregon

MARI 3986

Well Record 6-206

STATE WELL NO. 6/24-13H(1)
COUNTY Marion
APPLICATION NO. GR-206


G-6477

OWNER: Maurice Hynes
MAILING ADDRESS Rt. 2, Box 197

CITY AND STATE: Silvarton, Oregon

LOCATION OF WELL: Owner's No. N. E.
SE 1/4 NE 1/4 Sec. 13 T. 6 S., R. 2 W., W.M.

Bearing and distance from section or subdivision
corner 2113.45' S. & 1000.0' W. of NE Cor.
Sec. 13

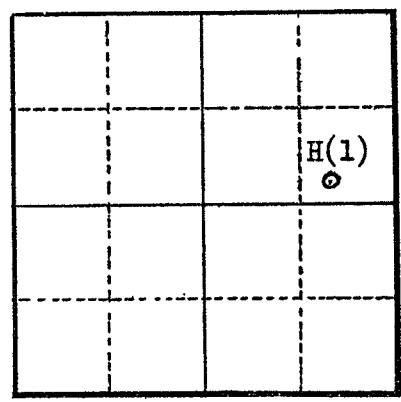

Section 13

Altitude at well 185 interpolated

TYPE OF WELL: drilled Date Constructed March 1956

Depth drilled 204 Depth cased

CASING RECORD:

10" set from 0 to 204 feet

FINISH:

perforations from 134 to 162, and 174 to 200 feet

AQUIFERS:

sand and gravel

WATER LEVEL:

38 feet below land surface, March 1956

PUMPING EQUIPMENT: Type _____ H.P. _____
Capacity _____ G.P.M.

WELL TESTS:

Drawdown 34 ft. after 2 hours pumping 400 G.P.M.
Drawdown 48 ft. after 1 1/2 hours pumping 500 G.P.M.

USE OF WATER Irrigation Temp. 58 °F. March 1956

SOURCE OF INFORMATION Will Drillers Report

DRILLER or DIGGER J. A. Sneed and Sons

ADDITIONAL DATA:

Log Water Level Measurements _____ Chemical Analysis _____ Aquifer Test _____

REMARKS:

WELL DRILLERS REPORT IN FILE G-206

