

STATE ENGINEER  
Salem, Oregon

MAR 31 1953

# Well Record


STATE WELL NO. 6/2W-13N(1)  
COUNTY Marion  
APPLICATION NO. GR-387

OWNER: George S. May  
MAILING ADDRESS: P.O. Box 49

CITY AND STATE: Mt. Angel, Oregon

LOCATION OF WELL: Owner's No. \_\_\_\_\_  
SW. 1/4 SW. 1/4 Sec. 13 T. 6 N. S. R. 2 W., W.M.

Bearing and distance from section or subdivision  
corner 20 ch. N. & 8 ch. E. from SW Cor. Sec. 13

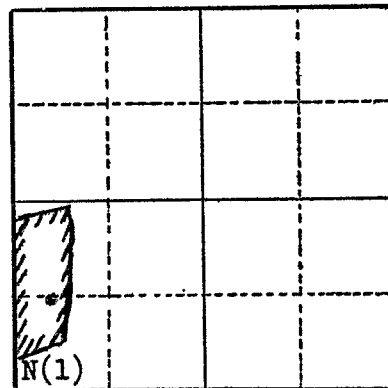

Section 13

Altitude at well 152'

TYPE OF WELL: Drilled Date Constructed Aug. 1953

Depth drilled 140 Depth cased 140

### CASING RECORD:

8

### FINISH:

### AQUIFERS:

### WATER LEVEL:

30

PUMPING EQUIPMENT: Type Jacuzzi Turbine H.P. 15  
Capacity 400 G.P.M.

### WELL TESTS:

Drawdown \_\_\_\_\_ ft. after \_\_\_\_\_ hours \_\_\_\_\_ G.P.M.  
Drawdown \_\_\_\_\_ ft. after \_\_\_\_\_ hours \_\_\_\_\_ G.P.M.

USE OF WATER Irrigation Temp. \_\_\_\_\_ °F., 19

SOURCE OF INFORMATION GR-387

DRILLER or DIGGER ?

### ADDITIONAL DATA:

Log <sup>X</sup> Water Level Measurements \_\_\_\_\_ Chemical Analysis \_\_\_\_\_ Aquifer Test \_\_\_\_\_

### REMARKS:

