

STATE ENGINEER
Salem, Oregon

MARI... 4042

Well Record

STATE WELL NO. 6/2W-15B
COUNTY Marion
APPLICATION NO. GR-3261

OWNER: Frank Henny

MAILING ADDRESS: Route 1, Box 160 **B lot 2**

LOCATION OF WELL: Owner's No.

CITY AND STATE: Brooks, Oregon

NW 1/4 NE 1/4 Sec. 15 T. 6 S., R. 2 W., W.M.

Bearing and distance from section or subdivision corner 18 1/2 ch. S. & 1 ch. E. from N 1/2 corner Section 15.

Altitude at well

TYPE OF WELL: drilled Date Constructed 1953

Depth drilled 155 Depth cased 155

Section

CASING RECORD:

8 inch

FINISH:

from 90 to 110
from 135 to 155

AQUIFERS:

Gravel

WATER LEVEL:

135 feet

PUMPING EQUIPMENT: Type Turbine H.P. 10
Capacity 250 G.P.M.

WELL TESTS:

Drawdown 40 ft. after hours pumping 900 G.P.M.

Drawdown ft. after hours G.P.M.

USE OF WATER Irrigation Temp. °F. 19

SOURCE OF INFORMATION GR-3034

DRILLER or DIGGER Rudy Stahl

ADDITIONAL DATA:

Log Water Level Measurements Chemical Analysis Aquifer Test

REMARKS:

Gravel	90	110
Gravel	135	155

STATE ENGINEER
Salem, Oregon

404
MAR 1954

Well Record

STATE WELL NO. 6/2W-15B(1)
COUNTY Marion
APPLICATION NO.

OWNER: Frank Henry

MAILING ADDRESS: Pg 2 of 2

LOCATION OF WELL: Owner's No.

CITY AND STATE:


1/4 Sec. T. N. S., R. E. W., W.M.

Bearing and distance from section or subdivision corner

Altitude at well 155

TYPE OF WELL: Drilled Date Constructed 1954

Depth drilled 155 Depth cased 155

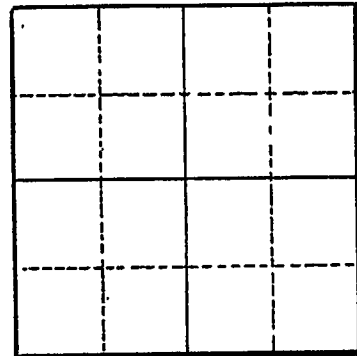

Section

CASING RECORD:

8 inch

FINISH:

Casing perforated 90 to 110, 135 to 155

AQUIFERS:

Gravel from 90 to 110, 135 to 155

WATER LEVEL:

13 feet

PUMPING EQUIPMENT: Type Turbine H.P. 10
Capacity G.P.M.

WELL TESTS:

Drawdown ft. after hours G.P.M.
Drawdown ft. after hours G.P.M.

USE OF WATER Irrigation 49.5 acres Temp. °F. 19

SOURCE OF INFORMATION USGS

DRILLER or DIGGER

ADDITIONAL DATA:

Log Water Level Measurements Chemical Analysis Aquifer Test

REMARKS: