

STATE ENGINEER
Salem, Oregon

4044 Well Record


STATE WELL NO. 6/2W-15E(1)
COUNTY Marion
APPLICATION NO. GR-206

OWNER: Silas F. Parlich MAILING ADDRESS: Rt. 1, Box 221

LOCATION OF WELL: Owner's No. #1 CITY AND STATE: Brooks, Oregon

SW 1/4 NW 1/4 Sec. 15 T. 6 S., R. 2 W., W.M.

Bearing and distance from section or subdivision corner S. 68° 37' E. 33 chains & N. 20° 16' E. 50' from NE Corner D.L.C. #67

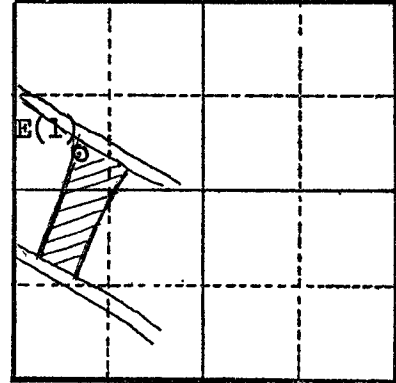

Section 15

Altitude at well 149' Interpolated

TYPE OF WELL: Drilled Date Constructed Jan. 2, 1951

Depth drilled 86' Depth cased 80

CASING RECORD:

10" casing set from 0 to 80'

FINISH:

None

AQUIFERS:

Sand & gravel 65 to 86'

WATER LEVEL:

30' below land surface 9/1/51

PUMPING EQUIPMENT: Type Berkeley Turbine H.P. 5

Capacity 100 G.P.M.

WELL TESTS:

Drawdown 84 ft. after hours pumping 165 G.P.M.

Drawdown ft. after hours G.P.M.

USE OF WATER Irrigation 16 acres Temp. °F. 19

SOURCE OF INFORMATION Registration Statement GR-206

DRILLER or DIGGER

ADDITIONAL DATA:

Log X Water Level Measurements Chemical Analysis Aquifer Test

REMARKS:

Clay 0 to 65'
Sand & gravel 65 to 80'
Gravel
(water-bearing) 80 to 86'