

STATE ENGINEER  
Salem, Oregon

MARTIN

# Well Record

STATE WELL NO. 6/2W-150  
COUNTY Marion  
APPLICATION NO. GR-1700

GR- 1649

OWNER: William Heilman


MAILING ADDRESS: Rt. 1, Box 213  
A\* G 776  
P\* G 777

LOCATION OF WELL: Owner's No.

CITY AND STATE: Brooks, Oregon

SW 1/4 SE 1/4 Sec. 15 T. 6 S. R. 2 W., W.M.

Bearing and distance from section or subdivision corner 250' N. & 50' E. from S<sup>1</sup>/<sub>4</sub> cor. Sec. 15

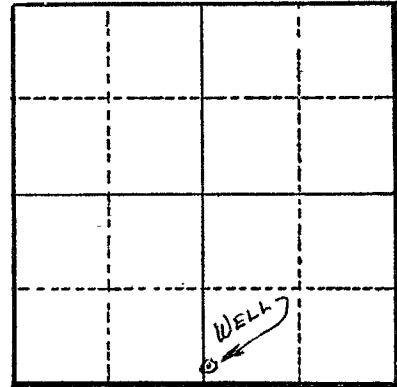

Section 15

Altitude at well 100'

TYPE OF WELL: Drilled Date Constructed 1950

Depth drilled 53' Depth cased 53'

### CASING RECORD:

8"

### FINISH:

Mills knife slot perforations from 40 to 50 ft.

### AQUIFERS:

Silt & pea gravel

### WATER LEVEL:

8'

PUMPING EQUIPMENT: Type Turbine H.P. 9  
Capacity 175 G.P.M.

### WELL TESTS:

Drawdown ft. after hours G.P.M.  
Drawdown ft. after hours G.P.M.

USE OF WATER Irrigation Temp. °F. 19

SOURCE OF INFORMATION GR Record

DRILLER or DIGGER D. L. Clement

### ADDITIONAL DATA:

Log N.A. Water Level Measurements Chemical Analysis Aquifer Test

### REMARKS:

Irrigation of 10 acres.