

STATE ENGINEER
Salem, Oregon

MARI...4088

Well Record

STATE WELL NO. 6/2W-16C(1)
COUNTY MARION
APPLICATION NO. GR-2667
C-6653

OWNER: Edna J. Ramp

MAILING ADDRESS:

Rt. 1, Box 66X

LOCATION OF WELL: Owner's No. #1

CITY AND STATE:

Brooks, Oregon

NE 1/4 NW 1/4 Sec. 16 T. 6 N. S. R. 2 W. W.M.

Bearing and distance from section or subdivision


corner 315' W. and 315' S.

2900 ft. East & 300 ft. South from NE corner of Section 16

Altitude at well 160

TYPE OF WELL: Drilled Date Constructed 1954

Depth drilled 75 Depth cased 75

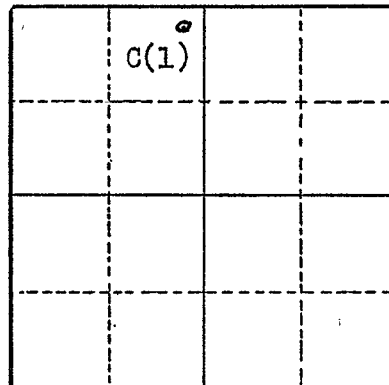

Section 16

CASING RECORD:

10-inch

FINISH:

100 Mills perforator from 67 to 75

AQUIFERS:

Topsoil, silt, sand, clay and gravel

WATER LEVEL:

Flowing well - estimated 180 to 200 gpm 7/20/60 W.S.B.

PUMPING EQUIPMENT: Type Yale fire pump H.P. 120
Capacity 500 G.P.M.

WELL TESTS:

Drawdown	ft. after	hours	Pumping 300	G.P.M.
Drawdown	ft. after	hours		G.P.M.

USE OF WATER Irrigation Temp. °F., 19

SOURCE OF INFORMATION GR-2529

DRILLER or DIGGER Orville Wymore, Rt. 1, Box 1, Brooks, Oregon

ADDITIONAL DATA:

Log Water Level Measurements Chemical Analysis Aquifer Test

REMARKS:

Topsoil	0	2
Yellow silt	2	26
Silty sand	26	31
Blue clay	31	49
Blue sandy clay	49	65
Sand & Gravel	65	75

