

STATE ENGINEER
Salem, Oregon

MARY... 4154

Well Record


STATE WELL NO. 6/2W-17A(1)
COUNTY Marion
APPLICATION NO. GR-427

OWNER: Assemblies of God, Ore. Dist. MAILING ADDRESS: Box 38

LOCATION OF WELL: Owner's No. #1 CITY AND STATE: Brooks, Oregon

NE 1/4 NE 1/4 Sec 17 T. 6 N. S., R. 2 E. W., W.M.

Bearing and distance from section or subdivision
corner 1054' S. & 956' W. from NE Cor. Sec. 17

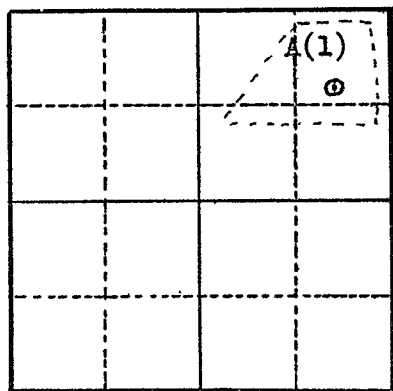

Section 17

Altitude at well 183 ft

TYPE OF WELL: Drilled Date Constructed Aug. 1, 1944

Depth drilled 80 Depth cased 80

CASING RECORD:

6"

FINISH:

AQUIFERS:

WATER LEVEL:

40

PUMPING EQUIPMENT: Type Jet H.P. 3

Capacity 20 G.P.M.

WELL TESTS:

Drawdown ft. after hours G.P.M.

Drawdown ft. after hours G.P.M.

USE OF WATER Domestic & camp meetings Temp. °F. 19

SOURCE OF INFORMATION GR-427

DRILLER or DIGGER

ADDITIONAL DATA:

Log No. Water Level Measurements Chemical Analysis Aquifer Test

REMARKS: